

Date: Tuesday, 22/04/2008 10:32:17 AM
 User: Julie Lecocq

Process Sheet

Customer : CU-DAR001 Dart Helicopters Services	Drawing Name : HELI UTILITY BASKET LH/RH 350/355
Job Number : 38726	
Estimate Number : 10208	
P.O. Number :	Part Number : D350607043
This Issue : 22/04/2008 S.O. No. :	Drawing Number : D350-607 REV F P7-9
Prsht Rev. : NC	Project Number : N/A
First Issue : // Type : LARGE FAB ASSY	Drawing Revision : F
Previous Run : 38725	Material :
Written By :	Due Date : 10/05/2008 Qty: 1 Um: Each
Checked & Approved By : <u>JLD 08.4.02</u>	
Comment : Est Rev:E as Per DSI9318 06-01-24 JLM	
Est Rev:F ECN1068 07-12-21 DD verified by:	


Additional Product

Job Number:



Seq. #:	Machine Or Operation:	Description :
----------------	------------------------------	----------------------

1.0	DC	DOCUMENT CONTROL
-----	----	------------------

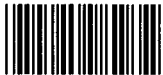**Comment:** DOCUMENT CONTROL

Photocopy bluefile & type labels per PPPD350-607-043 CHG004

08/05/07

JLD 8.4.02

2.0	38726A	BASKET LID ASSEMBLY
-----	--------	---------------------

**Comment:** Sub-Component BASKET LID ASSEMBLY

D2989-041 B 38726A

08/05/07 mil

3.0	38726B	BASKET LID ASSEMBLY
-----	--------	---------------------

**Comment:** Sub-Component BASKET LID ASSEMBLY

D2989-043 B 38726B

08/05/07 mil

4.0	38726C	BASKET BASE ASSEMBLY (350)
-----	--------	----------------------------

**Comment:** Sub-Component BASKET BASE ASSEMBLY (350)

D2221 B 38726C

08/05/07 mil

5.0	PACKAGING 1	PACKAGING RESOURCE #1
-----	-------------	-----------------------

**Comment:** PACKAGING RESOURCE #1

Pick: Assembly Kit

W/O:		WORK ORDER CHANGES					
DATE	STEP	PROCEDURE CHANGE	By	Date	Qty	Approval Chief Eng / Prod Mgr	Approval QC Inspector

Part No: _____ PAR #: _____ Fault Category: _____ NCR: Yes No DQA: _____ Date: _____

QA: N/C Closed: _____ Date: _____

NCR:		WORK ORDER NON-CONFORMANCE (NCR)						
DATE	STEP	Description of NC Section A	Corrective Action Section B			Verification Section C	Approval Chief Eng	Approval QC Inspector
			Initial Chief Eng	Action Description Chief Eng	Sign & Date			

NOTE: Date & initial all entries

Date: Tuesday, 22/04/2008 10:32:17 AM
User: Julie Lecocq

Process Sheet

Customer: CU-DAR001 Dart Helicopters Services

Drawing Name: HELI.UTILITY.BASKET.LH/RH 350/355

Job Number: 38726

Part Number: D350607043

Job Number:



Seq. #:	Machine Or Operation:	Description :
---------	-----------------------	---------------

6.0	NAS1515H4	Washer
-----	-----------	--------



Comment: Qty.: 2.0000 Each(s)/Unit Total : 2.0000 Each(s)

Pick: Assembly Kit

Qty Part Number Description Batch

2 NAS1515H4 WASHER M106919

AS 08/05/06 (X)

7.0	D2022101	Spacer
-----	----------	--------



Comment: Qty.: 5.0000 Each(s)/Unit Total : 5.0000 Each(s)

Pick: Assembly Kit

Qty Part Number Description Batch

5 D2022-101 Spacer B33985

AS 08/05/06 (X)

8.0	D2258200	Placard 200lb
-----	----------	---------------



Comment: Qty.: 1.0000 Each(s)/Unit Total : 1.0000 Each(s)

Pick: Assembly Kit

Qty Part Number Description Batch

1 D2258-200 Label 36848

AS 08/05/06 (X)

9.0	D2332041	Lid Prop Assembly 6.69" long
-----	----------	------------------------------



Comment: Qty.: 1.0000 Each(s)/Unit Total : 1.0000 Each(s)

Pick: Assembly Kit

Qty Part Number Description Batch

1 D2332-041 Prop Ass'y 38597

AS 08/05/06 (X)

10.0	D2530	Handle Weldment
------	-------	-----------------



Comment: Qty.: 1.0000 Each(s)/Unit Total : 1.0000 Each(s)

Pick: Assembly Kit

Qty Part Number Description Batch

1 D2530 Handle Weldment 37546

AS 08/05/06 (X)

11.0	D2535	Spring
------	-------	--------



Comment: Qty.: 2.0000 Each(s)/Unit Total : 2.0000 Each(s)

Pick: Assembly Kit

Qty Part Number Description Batch

2 D2535 Spring 37071

AS 08/05/06 (X)

W/O:		WORK ORDER CHANGES					
DATE	STEP	PROCEDURE CHANGE	By	Date	Qty	Approval Chief Eng / Prod Mgr	Approval QC Inspector

Part No: _____ PAR #: _____ Fault Category: _____ NCR: Yes No DQA: _____ Date: _____

QA: N/C Closed: _____ Date: _____

NCR:		WORK ORDER NON-CONFORMANCE (NCR)						
DATE	STEP	Description of NC Section A	Corrective Action Section B			Verification Section C	Approval Chief Eng	Approval QC Inspector
			Initial Chief Eng	Action Description Chief Eng	Sign & Date			

NOTE: Date & initial all entries

Date: Tuesday, 22/04/2008 10:32:17 AM
User: Julie Lecocq

Process Sheet

Customer: CU-DAR001 Dart Helicopters Services

Drawing Name: HELI UTILITY: BASKET LH/RH 350/355

Job Number: 38726

Part Number: D350607043

Job Number:



Seq. #:

Machine Or Operation:

Description :

12.0

D2537

Bushing



Comment: Qty.: 2.0000 Each(s)/Unit Total : 2.0000 Each(s)

Pick: Assembly Kit

Qty Part Number

Description Batch

2 D2537

Bushing

37608

JS 08/05/06 (X)

13.0

D27283

Dart Logo Label - large



Comment: Qty.: 2.0000 Each(s)/Unit Total : 2.0000 Each(s)

Pick: Assembly Kit

Qty Part Number

Description Batch

2 D2728-3

Label

22553

JS 08/05/06 (X)

14.0

D2931

Bumper



Comment: Qty.: 2.0000 Each(s)/Unit Total : 2.0000 Each(s)

Pick: Assembly Kit

Qty Part Number

Description Batch

2 D2931

Bumper

21139

JS 08/05/06 (X)

15.0

AN316A

Bolt



Comment: Qty.: 2.0000 Each(s)/Unit Total : 2.0000 Each(s)

Pick: Assembly Kit

Qty Part Number

Description Batch

2 AN3-16A

Bolt

M106815

JS 08/05/06 (X)

16.0

AN413A

Bolt



Comment: Qty.: 2.0000 Each(s)/Unit Total : 2.0000 Each(s)

Pick: Assembly Kit

Qty Part Number

Description Batch

2 AN4-13A

Bolt

M107534

JS 08/05/06 (X)

17.0

AN422A

Bolt



Comment: Qty.: 7.0000 Each(s)/Unit Total : 7.0000 Each(s)

Pick: Assembly Kit

Qty Part Number

Description Batch

7 AN4-22A

Bolt

M104937

JS 08/05/06 (X)

W/O:		WORK ORDER CHANGES					
DATE	STEP	PROCEDURE CHANGE	By	Date	Qty	Approval Chief Eng / Prod Mgr	Approval QC Inspector

Part No: _____ PAR #: _____ Fault Category: _____ NCR: Yes No DQA: _____ Date: _____

QA: N/C Closed: _____ Date: _____

NCR:		WORK ORDER NON-CONFORMANCE (NCR)						
DATE	STEP	Description of NC Section A	Corrective Action Section B			Verification Section C	Approval Chief Eng	Approval QC Inspector
			Initial Chief Eng	Action Description Chief Eng	Sign & Date			

NOTE: Date & initial all entries

Date: Tuesday, 22/04/2008 10:32:17 AM
User: Julie Lecocq

Process Sheet

Customer: CU-DAR001 Dart Helicopters Services

Drawing Name: HELI UTILITY BASKET LH/RH 350/355

Job Number: 38726

Part Number: D350607043

Job Number:



Seq. #:	Machine Or Operation:	Description :
---------	-----------------------	---------------

18.0	AN517A	Bolt
------	--------	------



Comment: Qty.: 4.0000 Each(s)/Unit Total : 4.0000 Each(s)

Pick: Assembly Kit

Qty Part Number Description Batch

4 AN5-17A Bolt M107242

AS 08/05/06 (X)

19.0	AN960JD8	Washer
------	----------	--------



Comment: Qty.: 2.0000 Each(s)/Unit Total : 2.0000 Each(s)

Pick: Assembly Kit

Qty Part Number Description Batch

2 AN960JD8 Washer M107091

AS 08/05/06 (X)

20.0	AN960JD416	Washer
------	------------	--------



Comment: Qty.: 14.0000 Each(s)/Unit Total : 14.0000 Each(s)

Pick: Assembly Kit

Qty Part Number Description Batch

14 AN960JD416 Washer M107321

AS 08/05/06 (X)

21.0	AN960JD416L	Washer
------	-------------	--------



Comment: Qty.: 2.0000 Each(s)/Unit Total : 2.0000 Each(s)

Pick: Assembly Kit

Qty Part Number Description Batch

2 AN960JD416L Washer M07008

AS 08/05/06 (X)

22.0	AN960JD516	Washer
------	------------	--------



Comment: Qty.: 4.0000 Each(s)/Unit Total : 4.0000 Each(s)

Pick: Assembly Kit

Qty Part Number Description Batch

4 AN960JD516 Washer M107534

AS 08/05/06 (X)

23.0	AN9704	Washer
------	--------	--------



Comment: Qty.: 4.0000 Each(s)/Unit Total : 4.0000 Each(s)

Pick: Assembly Kit

Qty Part Number Description Batch

4 AN970-4 Washer 67242

AS 08/05/06 (X)

W/O:		WORK ORDER CHANGES					
DATE	STEP	PROCEDURE CHANGE	By	Date	Qty	Approval Chief Eng / Prod Mgr	Approval QC Inspector

Part No: _____ PAR #: _____ Fault Category: _____ NCR: Yes No DQA: _____ Date: _____

QA: N/C Closed: _____ Date: _____

NCR:		WORK ORDER NON-CONFORMANCE (NCR)						
DATE	STEP	Description of NC Section A	Corrective Action Section B			Verification Section C	Approval Chief Eng	Approval QC Inspector
			Initial Chief Eng	Action Description Chief Eng	Sign & Date			

NOTE: Date & initial all entries

Date: Tuesday, 22/04/2008 10:32:17 AM
User: Julie Lecocq

Process Sheet

Customer: CU-DAR001 Dart Helicopters Services

Drawing Name: HELI UTILITY BASKET LH/RH 350/355 -

Job Number: 38726

Part Number: D350607043

Job Number:



Seq. #:

Machine Or Operation:

Description :

24.0

MS20600AD4W3

Cherry Rivets



Comment: Qty.: 2.0000 Each(s)/Unit Total : 2.0000 Each(s)

Pick: Assembly Kit

Qty Part Number Description Batch

2 MS20600AD4W3 Rivet M18071

JS 08/05/06 (X)

25.0

MS21042L3

Nut



Comment: Qty.: 2.0000 Each(s)/Unit Total : 2.0000 Each(s)

Pick: Assembly Kit

Qty Part Number Description Batch

2 MS21042L3 Nut (or -3) M107644

JS 08/05/06 (X)

26.0

MS21042L4

Nut



Comment: Qty.: 9.0000 Each(s)/Unit Total : 9.0000 Each(s)

Pick: Assembly Kit

Qty Part Number Description Batch

9 MS21042L4 Nut (or -4) M106051

JS 08/05/06 (X)

27.0

MS21042L5

Nut



Comment: Qty.: 4.0000 Each(s)/Unit Total : 4.0000 Each(s)

Pick: Assembly Kit

Qty Part Number Description Batch

4 MS21042L5 Nut (or -5) M106785

JS 08/05/06 (X)

28.0

SMALL FAB 1

SMALL & MEDIUM FAB RESOURCE 1



Comment: SMALL & MEDIUM FAB RESOURCE 1

Assemble as per Dwg D350-607

Seal Support Gusset with Sikaflex -291

Batch: M117809

Exp Date: 10/2008

ml 08/05/07 X1

Dart Aerospace Ltd

W/O:		WORK ORDER CHANGES					
DATE	STEP	PROCEDURE CHANGE	By	Date	Qty	Approval Chief Eng / Prod Mgr	Approval QC Inspector

Part No: _____ PAR #: _____ Fault Category: _____ NCR: Yes No DQA: _____ Date: _____
 QA: N/C Closed: _____ Date: _____

NCR:		WORK ORDER NON-CONFORMANCE (NCR)						
DATE	STEP	Description of NC Section A	Corrective Action Section B			Verification Section C	Approval Chief Eng	Approval QC Inspector
			Initial Chief Eng	Action Description Chief Eng	Sign & Date			

NOTE: Date & initial all entries

Date: Tuesday, 22/04/2008 10:32:17 AM
User: Julie Lecocq

Process Sheet

Customer: CU-DAR001 Dart Helicopters Services

Drawing Name: HELI UTILITY-BASKET-LH/RH 350/355

Job Number: 38726

Part Number: D350607043

Job Number:



Seq. #: Machine Or Operation: Description :

29.0

QC5

INSPECT WORK TO CURRENT STEP



Comment: INSPECT WORK TO CURRENT STEP

Handwritten: 08/05/06 (X)

30.0

PACKAGING 1

PACKAGING RESOURCE #1



Comment: PACKAGING RESOURCE #1

Pick: Packing Kit

31.0

D22301

Lug



Comment: Qty.: 4.0000 Each(s)/Unit Total : 4.0000 Each(s)

Pick: Packing Kit

Qty Part Number

Description Batch

4 D2230-1

Lug

Handwritten: B38740

Handwritten: New BATCH 3131! Motion ramp

Handwritten: AS 08/05/06 (X)

32.0

D22303

Lug



Comment: Qty.: 4.0000 Each(s)/Unit Total : 4.0000 Each(s)

Pick: Packing Kit

Qty Part Number

Description Batch

4 D2230-3

Clamp

Handwritten: B37746

Handwritten: AS 08/05/06 (X)

33.0

D23241

Strut Assembly



Comment: Qty.: 1.0000 Each(s)/Unit Total : 1.0000 Each(s)

Pick: Packing Kit

Qty Part Number

Description Batch

1 *D2324-1

Strut Ass'y

Handwritten: 36749

Handwritten: AS 08/05/06 (X)

34.0

D2732

Rubber Extrusion



Comment: Qty.: 2.0000 f(s)/Unit Total : 2.0000 f(s)

Rubber Extrusion

(8x-D2732-030 (cut to 3"))

Batch:

Handwritten: 37362

Handwritten: AS 08/05/06 (X)

W/O:		WORK ORDER CHANGES					
DATE	STEP	PROCEDURE CHANGE	By	Date	Qty	Approval Chief Eng / Prod Mgr	Approval QC Inspector

Part No: _____ PAR #: _____ Fault Category: _____ NCR: Yes No DQA: _____ Date: _____

QA: N/C Closed: _____ Date: _____

NCR:		WORK ORDER NON-CONFORMANCE (NCR)						
DATE	STEP	Description of NC Section A	Corrective Action Section B			Verification Section C	Approval Chief Eng	Approval QC Inspector
			Initial Chief Eng	Action Description Chief Eng	Sign & Date			

NOTE: Date & initial all entries

Date: Tuesday, 22/04/2008 10:32:17 AM
User: Julie Lecocq

Process Sheet

Customer: CU-DAR001 Dart Helicopters Services

Drawing Name: HELI UTILITY BASKET LH/RH 350/355

Job Number: 38726

Part Number: D350607043

Job Number:



Seq. #:	Machine Or Operation:	Description :
---------	-----------------------	---------------

35.0	AN412A	Bolt
------	--------	------



Comment: Qty.: 5.0000 Each(s)/Unit Total: 5.0000 Each(s)

Pick: Packing Kit

Qty Part Number

Description Batch

5 AN4-12A

Bolt

M105143

AS 08/05/06 (x1)

36.0	AN413A	Bolt
------	--------	------



Comment: Qty.: 2.0000 Each(s)/Unit Total: 2.0000 Each(s)

Pick: Packing Kit

Qty Part Number

Description Batch

2 AN4-13A

Bolt

M107534

AS 08/05/06 (x1)

37.0	AN415A	Bolt
------	--------	------



Comment: Qty.: 8.0000 Each(s)/Unit Total: 8.0000 Each(s)

Bolt

Batch:

M107321

AS 08/05/06 (x1)

38.0	AN960JD416	Washer
------	------------	--------



Comment: Qty.: 26.0000 Each(s)/Unit Total: 26.0000 Each(s)

Pick: Packing Kit

Qty Part Number

Description Batch

26 AN960JD416

Washer

M107321

AS 08/05/06 (x1)

39.0	MS21042L4	Nut
------	-----------	-----



Comment: Qty.: 13.0000 Each(s)/Unit Total: 13.0000 Each(s)

Pick: Packing Kit

Qty Part Number

Description Batch

13 MS21042L4

Nut (or -4)

M106051

AS 08/05/06 (x1)

40.0	QC4	INSPECT 100% KITS FOR COMPLETENESS
------	-----	------------------------------------



Comment: INSPECT 100% KITS FOR COMPLETENESS

AS 08/05/06 (x1)

W/O:		WORK ORDER CHANGES					
DATE	STEP	PROCEDURE CHANGE	By	Date	Qty	Approval Chief Eng / Prod Mgr	Approval QC Inspector

Part No: _____ PAR #: _____ Fault Category: _____ NCR: Yes No DQA: _____ Date: _____

QA: N/C Closed: _____ Date: _____

NCR:		WORK ORDER NON-CONFORMANCE (NCR)						
DATE	STEP	Description of NC Section A	Corrective Action Section B			Verification Section C	Approval Chief Eng	Approval QC Inspector
			Initial Chief Eng	Action Description Chief Eng	Sign & Date			

NOTE: Date & initial all entries

Date: Tuesday, 22/04/2008 10:32:17 AM
User: Julie Lecocq

Process Sheet

Customer: CU-DAR001 Dart Helicopters Services

Drawing Name: HELI UTILITY BASKET LH/RH 350/355

Job Number: 38726

Part Number: D350607043

Job Number:



Seq. #:

Machine Or Operation:

Description :

41.0

PACKAGING 1

PACKAGING RESOURCE #1



Comment: PACKAGING RESOURCE #1

Identify and pack for shipping as per PPP D350-607-043

Location: _____

F *08/05/08* *(1)*

42.0

QC21

FINAL INSPECTION/W/O RELEASE



08/05/08 *MF*

Comment: FINAL INSPECTION/W/O RELEASE

Job Completion



MF 08-05-07

W/O:		WORK ORDER CHANGES					
DATE	STEP	PROCEDURE CHANGE	By	Date	Qty	Approval Chief Eng / Prod Mgr	Approval QC Inspector

Part No: _____ PAR #: _____ Fault Category: _____ NCR: Yes No DQA: _____ Date: _____

QA: N/C Closed: _____ Date: _____

NCR:		WORK ORDER NON-CONFORMANCE (NCR)						
DATE	STEP	Description of NC Section A	Corrective Action Section B			Verification Section C	Approval Chief Eng	Approval QC Inspector
			Initial Chief Eng	Action Description Chief Eng	Sign & Date			

NOTE: Date & initial all entries

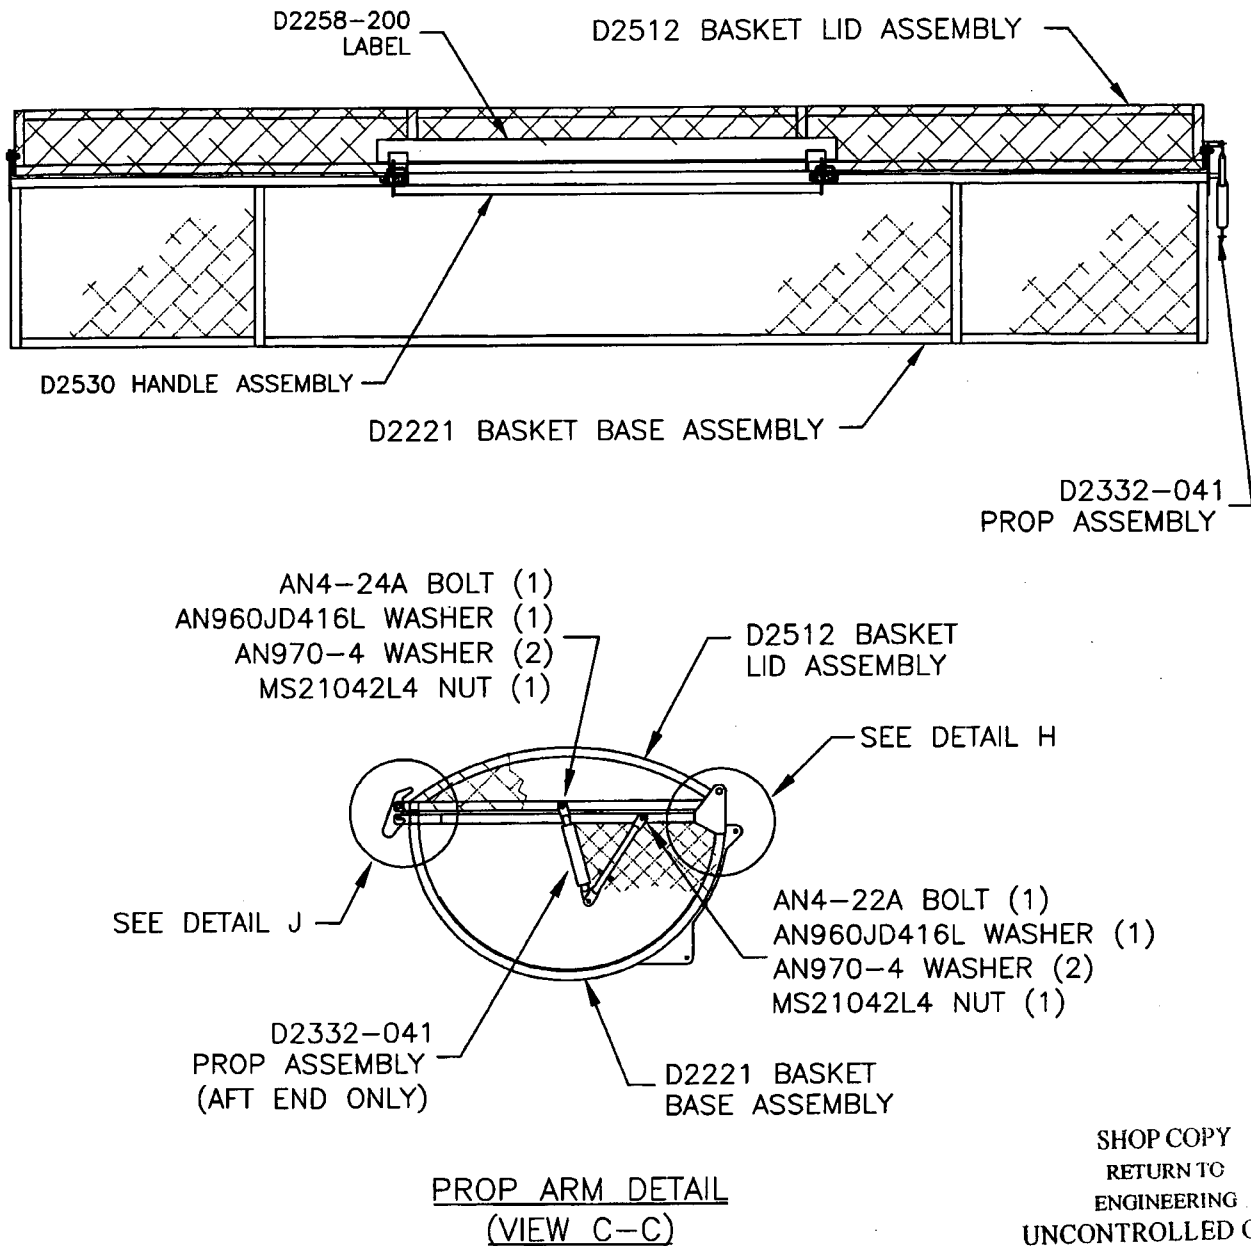


Figure 4 – Basket Replacement Parts
(D350-607-041 Heli-Utility-Basket™)

SHOP COPY
RETURN TO
ENGINEERING
UNCONTROLLED COPY
SUBJECT TO AMENDMENT
WITHOUT NOTICE
WORK ORDER
NO. 38726

• COPYRIGHT © 1994 BY DART AEROSPACE LTD. •
THIS DOCUMENT IS PRIVATE AND CONFIDENTIAL AND IS SUPPLIED ON THE EXPRESS CONDITION THAT IT IS NOT TO BE USED FOR ANY PURPOSE OR COPIED
OR COMMUNICATED TO ANY OTHER PERSON WITHOUT WRITTEN PERMISSION FROM DART AEROSPACE LTD.

Revision: F
Date: 03.01.17


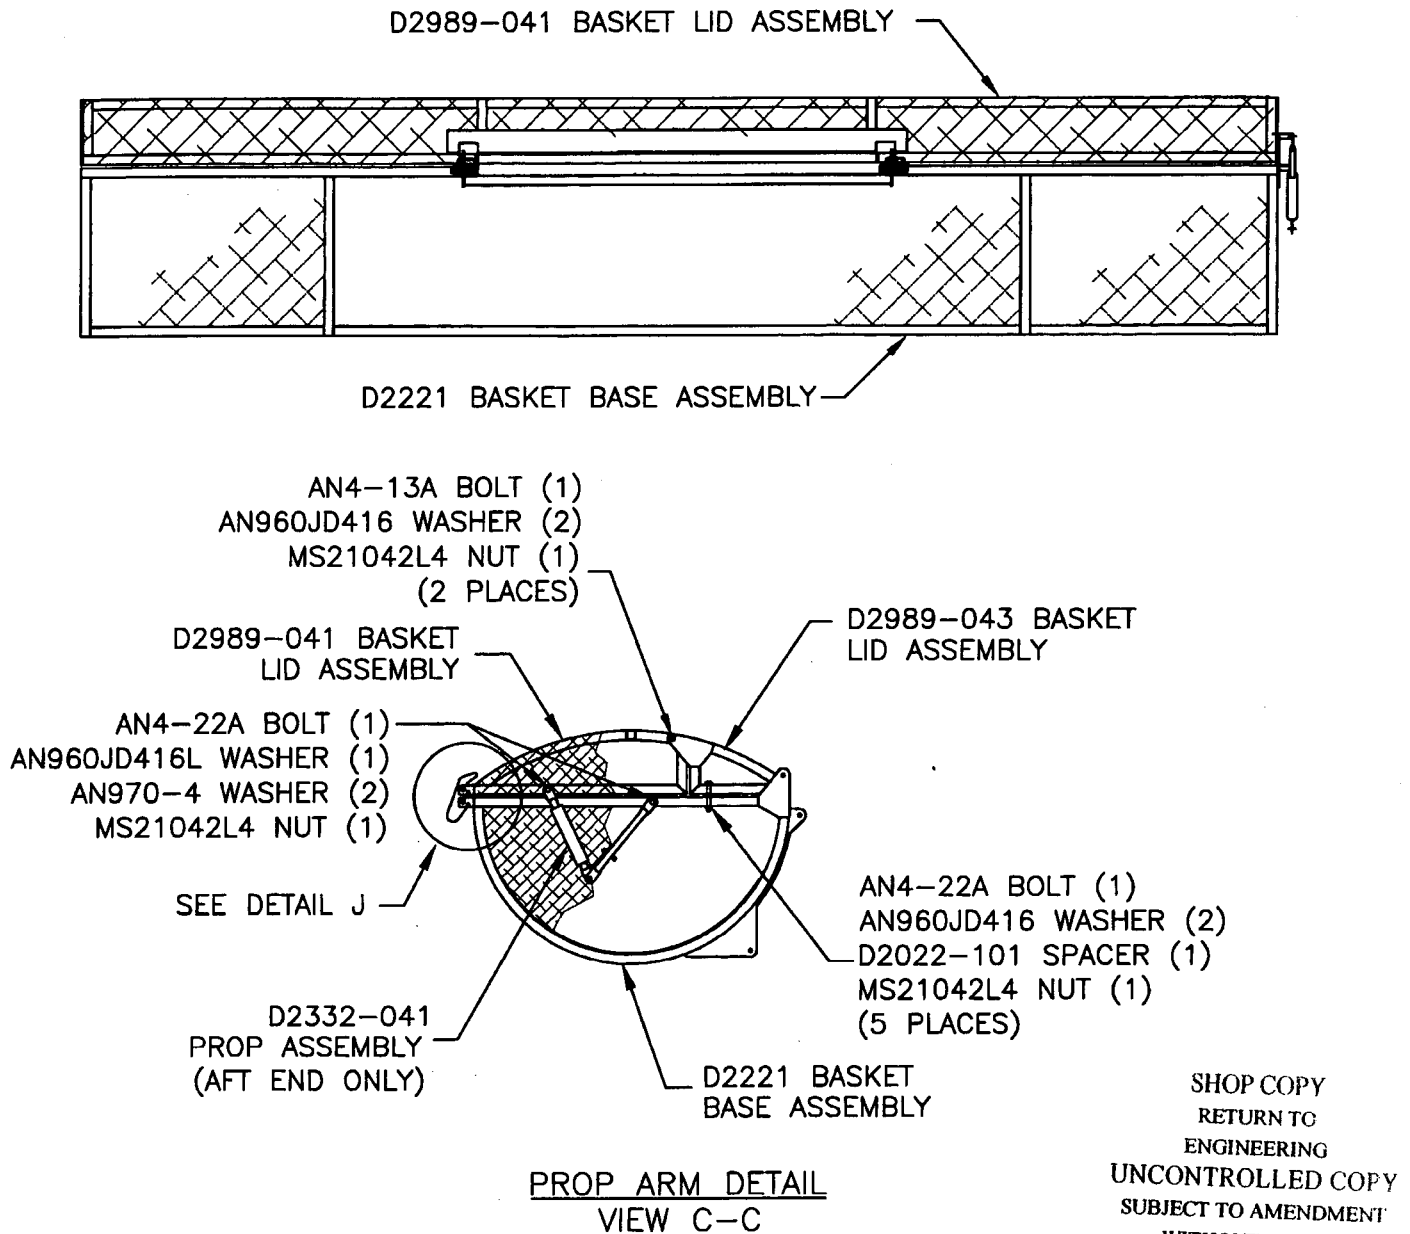



Figure 5- Basket Replacement Parts
(D350-607-043 Heli-Utility-Basket™)

• COPYRIGHT © 1994 BY DART AEROSPACE LTD. •
THIS DOCUMENT IS PRIVATE AND CONFIDENTIAL AND IS SUPPLIED ON THE EXPRESS CONDITION THAT IT IS NOT TO BE USED FOR ANY PURPOSE OR COPIED OR COMMUNICATED TO ANY OTHER PERSON WITHOUT WRITTEN PERMISSION FROM DART AEROSPACE LTD.

Revision: **F**
Date: 03.01.17

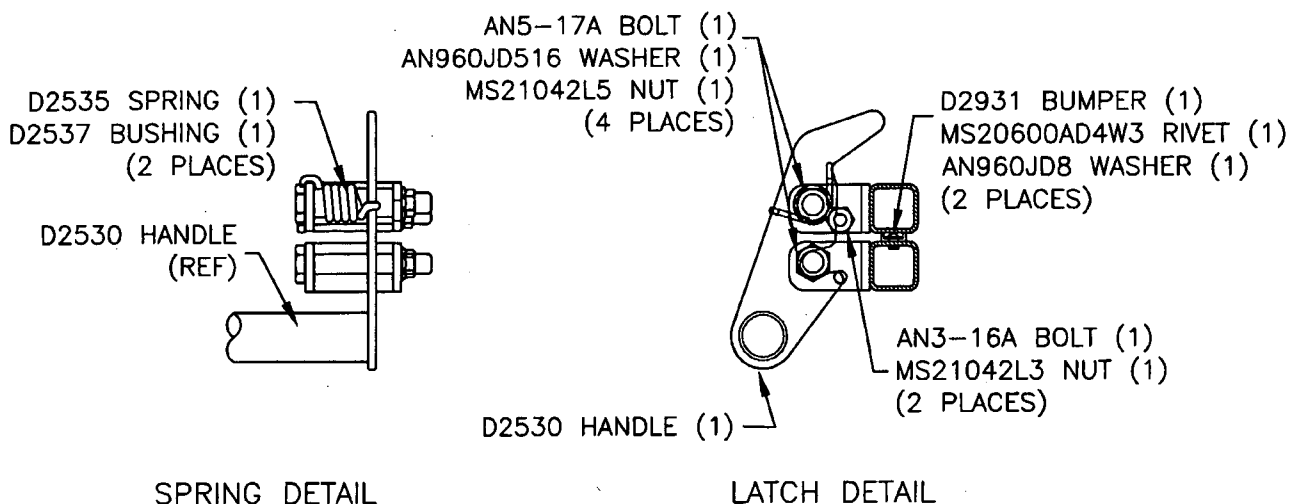

DETAIL J:
HANDLE WELDMENT

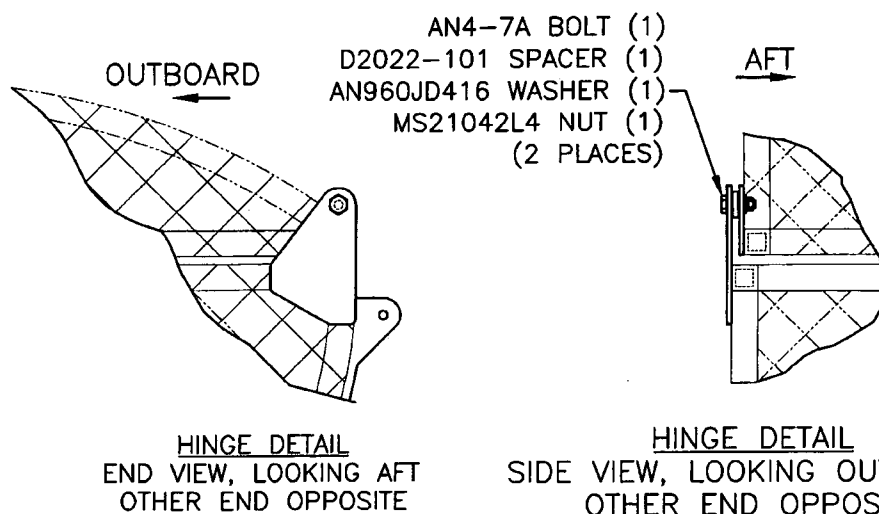

DETAIL H:
HINGE

SHOP COPY
RETURN TO
ENGINEERING
UNCONTROLLED COPY
SUBJECT TO AMENDMENT
WITHOUT NOTICE
WORK ORDER
NO. 38726

Figure 6 - Basket Replacement Parts

• COPYRIGHT © 1994 BY DART AEROSPACE LTD. •
THIS DOCUMENT IS PRIVATE AND CONFIDENTIAL AND IS SUPPLIED ON THE EXPRESS CONDITION THAT IT IS NOT TO BE USED FOR ANY PURPOSE OR COPIED OR COMMUNICATED TO ANY OTHER PERSON WITHOUT WRITTEN PERMISSION FROM DART AEROSPACE LTD.

Revision: F
Date: 03.01.17

4. WEIGHT AND BALANCE

Installation	Weight	LATERAL		LONGITUDINAL	
		Arm	Moment	Arm	Moment
D350-607-041/-043 (LH installation)	88 lb 39.9 kg	- 48 in - 1.22 m	- 4224 in-lb - 48.7 m-kg	135 in 3.43 m	-11880 in-lb -136.9 m-kg
D350-607-041/-043 (RH installation)	88 lb 39.9 kg	+ 48 in + 1.22 m	+ 4224 in-lb + 48.7 m-kg	135 in 3.43 m	11880 in-lb 136.9 m-kg

5. PARTS LIST

Qty -041	Qty -043	Part Number	Description
X		D350-607-041	HELI-UTILITY-BASKET
	X	D350-607-043	HELI-UTILITY-BASKET
2	5	D2022-101	SPACER
1	1	D2221	BASKET BASE ASSEMBLY
4	4	D2230-1	LUG
4	4	D2230-3	CLAMP
1	1	D2258-200	LABEL
1	1	D2324	STRUT
1	1	D2332-041	PROP ASSEMBLY
1		D2512	BASKET LID ASSEMBLY
1	1	D2530	HANDLE WELDMENT
2	2	D2535	SPRING
2	2	D2537	BUSHING
4	4	D2856-400-720	ABRASION STRIP
2	2	D2931	BUMPER
	1	D2989-041	BASKET LID ASSEMBLY (OUTSIDE)
	1	D2989-043	BASKET LID ASSEMBLY (INSIDE)
2	2	AN3-16A	BOLT
2		AN4-7A	BOLT
5	5	AN4-12A	BOLT
8	10	AN4-13A	BOLT
1	7	AN4-22A	BOLT
1		AN4-24A	BOLT
4	4	AN5-17A	BOLT
2	2	MS20600AD4W3	RIVET (OR CR9163-4-3)
28	40	AN960JD416	WASHER
2	2	AN960JD416L	WASHER
4	4	AN960JD516	WASHER
2	2	AN960JD8	WASHER
4	4	AN970-4	WASHER
2	2	MS21042L3	NUT (OR MS21042-3)
17	22	MS21042L4	NUT (OR MS21042-4)
4	4	MS21042L5	NUT (OR MS21042-5)

SHOP COPY
RETURN TO
ENGINEERING
UNCONTROLLED COPY
SUBJECT TO AMENDMENT
WITHOUT NOTICE
WORK ORDER
NO. 38726



DESIGN <i>CP</i>	DRAWN BY <i>CP</i>	DART AEROSPACE LTD HAWKESBURY, ONTARIO, CANADA	
CHECKED <i>[Signature]</i>	APPROVED <i>[Signature]</i>	DRAWING NO. DSI 9318	REV. A SHEET 1 OF 1
DATE 06.01.06		TITLE WASHER ADDITION	SCALE NTS
A	06.01.06	NEW ISSUE	

DART SERVICE INSTRUCTION

TO AMEND INSTALLATION INSTRUCTIONS D350-607 REV. F

REF. CANADIAN STC: SH94-14 ISSUE 4

REF. FAA STC: SR00213NY


To reduce the possibility of damaging the finish, a **NAS1515H4** washer (2 places) has been added between the hinge plate and basket frame on the **D350-607-043/-047 Heli-Utility-Basket**.

The corrected bolt stackup from Figure 5 of installation instructions D350-607 Rev. F is given below:

AN4-13A BOLT (1)
AN960JD416 WASHER (1)
HINGE PLATE (REF)
NAS1515H4 WASHER (1)
BASKET FRAME (REF)
AN960JD416 WASHER (1)
MS21042L4 NUT (1)
(2 PLACES)

BASKET FRAME (REF)

HINGE PLATE (REF)

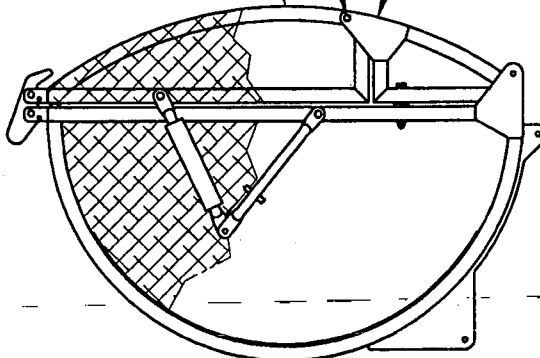

SHOP COPY
RETURN TO
ENGINEERING
UNCONTROLLED COPY
SUBJECT TO AMENDMENT
WITHOUT NOTICE
WORK ORDER
NO. 38726

CANADA
DEPARTMENT OF TRANSPORT
AIRCRAFT CERTIFICATION
BRANCH
DAO # 01-O-01

APPROVED
BY: *[Signature]*
D. SHEPHERD (DE # 02)

DATE: 06.01.06
CERT. NO.: SH94-14
ISSUE NO.: 4

Copyright © 2006 by DART AEROSPACE LTD

THIS DOCUMENT IS PRIVATE AND CONFIDENTIAL AND IS SUPPLIED ON THE EXPRESS CONDITION THAT IT IS NOT TO BE USED FOR ANY PURPOSE OR COPIED OR COMMUNICATED TO ANY OTHER PERSON WITHOUT WRITTEN PERMISSION FROM DART AEROSPACE LTD.

Date: Tuesday, 22/04/2008 10:32:37 AM
 User: Julie Lecocq

Process Sheet

Customer : CU-DAR001 Dart Helicopters Services	Drawing Name : BASKET BASE ASSEMBLY (350)
Job Number : 38726C	
Estimate Number : 10189	
P.O. Number :	Part Number : D2221 <i>08.04.22</i>
This Issue : 22/04/2008 S.O. No. :	Drawing Number : D2221 U D2235
Prsht Rev. : NC	Project Number : N/A
First Issue : // Type : LARGE FAB ASSY	Drawing Revision : F/B1
Previous Run : 38725C	Material :
Written By :	Due Date : 10/05/2008 Qty: 1 Um: Each
Checked & Approved By : <i>JLD 08.4.22</i>	
Comment : Est Rev:J 05.09.02 Added D3442-1KJ/JLM	

Additional Product

Job Number:



Seq. #:	Machine Or Operation:	Description :
----------------	------------------------------	----------------------

1.0	D31661	Basket Hoop
-----	--------	-------------



Comment: Qty.: 4.0000 Each(s)/Unit Total : 4.0000 Each(s)

Pick:

Qty	Part Number	Description	Batch
-----	-------------	-------------	-------

4	D3166-1	RIB	<i>337882</i>
---	---------	-----	---------------

2.0	D22323	Basket Hinge
-----	--------	--------------



Comment: Qty.: 2.0000 Each(s)/Unit Total : 2.0000 Each(s)

Pick:

Qty	Part Number	Description	Batch
-----	-------------	-------------	-------

2	D2232-3	Hinge bracket	<i>336846</i>
---	---------	---------------	---------------

3.0	D2325	Support Gusset (350 Basket)
-----	-------	-----------------------------



Comment: Qty.: 4.0000 Each(s)/Unit Total : 4.0000 Each(s)

Pick:

Qty	Part Number	Description	Batch
-----	-------------	-------------	-------

4	D2325	Support Gusset	<i>336691</i>
---	-------	----------------	---------------

4.0	D23273	Spacer Bushing
-----	--------	----------------



Comment: Qty.: 2.0000 Each(s)/Unit Total : 2.0000 Each(s)

Pick:

Qty	Part Number	Description	Batch
-----	-------------	-------------	-------

2	D2327-3	Bushing	<i>337851</i>
---	---------	---------	---------------

W/O:		WORK ORDER CHANGES					
DATE	STEP	PROCEDURE CHANGE	By	Date	Qty	Approval Chief Eng / Prod Mgr	Approval QC Inspector

Part No: _____ PAR #: _____ Fault Category: _____ NCR: Yes No DQA: _____ Date: _____

QA: N/C Closed: _____ Date: _____

NCR:		WORK ORDER NON-CONFORMANCE (NCR)						
DATE	STEP	Description of NC Section A	Corrective Action Section B			Verification Section C	Approval Chief Eng	Approval QC Inspector
			Initial Chief Eng	Action Description Chief Eng	Sign & Date			

NOTE: Date & initial all entries

Process Sheet

Customer: CU-DAR001 Dart Helicopters Services

Drawing Name: BASKET BASE ASSEMBLY (350)

Job Number: 38726C

Part Number: D2221

Job Number:



Seq. #:

Machine Or Operation:

Description :

5.0

D2581

Mounting Bracket



Comment: Qty.: 2.0000 Each(s)/Unit Total : 2.0000 Each(s)

Pick:

Qty Part Number Description Batch

2 D2581 Mounting Bracket B37213

✓

PD

08-05-06

6.0

D34421

Shim



Comment: Qty.: 2.0000 Each(s)/Unit Total : 2.0000 Each(s)

Pick:

Qty Part Number Description Batch

2 D3442-1 Shim B37615

✓

PD

08-05-06

7.0

M304EX07516F

Expanded Metal Flat Stai



Comment: Qty.: 41.6745 sf(s)/Unit Total : 41.6745 sf(s)

Pick:

Qty Part Number Description Batch

39.69 sf M304EX0.75-16F Expanded Metal M107316

✓

PD

08-05-06

8.0

M304TS0750W065

304 SQ Tube.75x.75x.065W



Comment: Qty.: 29.4000 f(s)/Unit Total : 29.4000 f(s)

Pick:

0-065 01.04-12

28' 3/4" x 3/4" x 0.063 wall 304/316 SStubing

Batch: M107515

✓

SAB

08/04/30

②

9.0

LARGE FAB 1

LARGE FABRICATION RESOURCE 1



Comment: LARGE FABRICATION RESOURCE 1

1-Cut D2235-1 Rib from D3166-1 Rib As Per Dwg D2235

SAB

08/05/01

①

2-Drill hole in D2221-3 as per Dwg D2221

3-Deburr

4-Remove all markings on material before welding

5-Weld as per Dwg D2221 using Welding Table and corner JigDeburr as required

CP

08-05-01 - WELD RIB

PD

08-05-06

Form: rprocess

W/O:		WORK ORDER CHANGES					
DATE	STEP	PROCEDURE CHANGE	By	Date	Qty	Approval Chief Eng / Prod Mgr	Approval QC Inspector

Part No: _____ PAR #: _____ Fault Category: _____ NCR: Yes No DQA: _____ Date: _____

QA: N/C Closed: _____ Date: _____

NCR:		WORK ORDER NON-CONFORMANCE (NCR)						
DATE	STEP	Description of NC Section A	Corrective Action Section B			Verification Section C	Approval Chief Eng	Approval QC Inspector
			Initial Chief Eng	Action Description Chief Eng	Sign & Date			


NOTE: Date & initial all entries

DART

DESIGN BW	DRAWN BY PH	DART AEROSPACE LTD HAWKESBURY, ONTARIO, CANADA	
CHECKED <i>H</i>	APPROVED <i>H</i>	DRAWING NO. D2221	REV. F SHEET 1 OF 3
DATE 05.06.07		TITLE BASKET BASE ASSEMBLY (350)	SCALE NTS
C	95.11.21	SEPARATE BASKET AND LID	
D	96.06.21	CHANGE LATCH	
E	01.04.19	CHANGE HINGE	
F	05.06.07	ADD SHIM UNDER HINGES, ADD HOLES FOR SPLIT LID BASKETS	

RELEASED05.08.19 *H***PARTS LIST FOR D2221 BASKET BASE ASSEMBLY**

PART NO	QUANTITY	LENGTH A	LENGTH B	DESCRIPTION
D2221-1	2	—	96.00	RIB
D2221-3	2	—	25.50	RIB
D2221-5	2	18.88	—	RIB
D2221-7	1	55.25	—	RIB
D2232-3	2	N/A	N/A	HINGE PLATE
D2235-1	4	N/A	N/A	RIB
D2325	4	N/A	N/A	SUPPORT GUSSET
D2327-3	2	N/A	N/A	BUSHING
D2581	2	N/A	N/A	MTG BRKT
D3442-1	2	N/A	N/A	SHIM

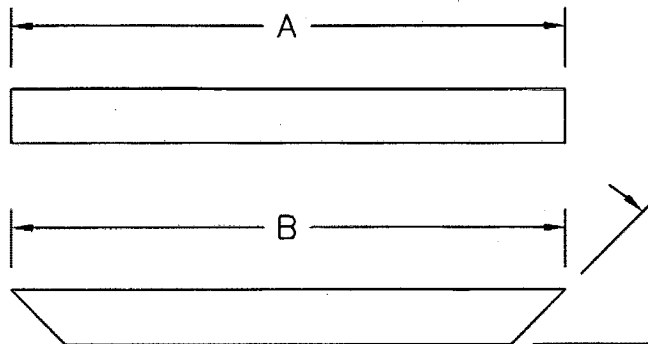

H 06.04.22
UNDER REVIEW
08.02.05 *H*
TUBING TO BE
CHANGED TO
WALL
RETURN TO
ENGINEERING
UNCONTROLLED COPY
SUBJECT TO AMENDMENT
WITHOUT NOTICE
WORK ORDER
NO. 387265

D2221-1/-3/-5/-7

- 1) CUT LENGTH/SHAPE PER DIAGRAM AND PARTS LIST
- 2) MATERIAL: AISI 304/316 SS, 3/4 X 3/4 X 0.060 WALL SQUARE TUBING
(REF. DART SPEC M304TS0.750W.060) 0.065 *H* 06.04.22
- 3) TOLERANCES ARE PER DART QSI 018 UNLESS OTHERWISE NOTED
- 4) ALL DIMENSIONS ARE IN INCHES
- 5) DRILL $\phi 0.257$ HOLES ONLY WHEN ASSEMBLING D2221 BASE WITH
D2989-041/-043 BASKET LID

Copyright © 1994 by DART AEROSPACE LTD

THIS DOCUMENT IS PRIVATE AND CONFIDENTIAL AND IS SUPPLIED ON THE EXPRESS CONDITION THAT IT IS NOT TO BE USED FOR ANY PURPOSE OR COPIED OR COMMUNICATED TO ANY OTHER PERSON WITHOUT WRITTEN PERMISSION FROM DART AEROSPACE LTD.

Date: Tuesday, 22/04/2008 10:32:37 AM
User: Julie Lecocq

Process Sheet

Customer: CU-DAR001 Dart Helicopters Services

Drawing Name: BASKET-BASE ASSEMBLY (350)

Job Number: 38726C

Part Number: D2221

Job Number:



Seq. #:

Machine Or Operation:

Description :

10.0

QC9

VISUAL WELDING INSPECTION



Comment: VISUAL WELDING INSPECTION

12/08/05/06

11.0

QC6

DIMENSIONAL CHECK



Comment: DIMENSIONAL CHECK

08/05/06 (E)

12.0

POWDER COATING

POWDER COATING



Comment: POWDER COATING

Powder Coat White Gloss (Ref: 4.3.5.1) as per QSI 005 4.3

41

08-05-07

(X)

13.0

QC3

INSPECT POWDER COAT/CHEMICAL CONVERSION



Comment: INSPECT POWDER COAT/CHEMICAL CONVERSION

M-4

08/05/07

14.0

QC21

FINAL INSPECTION/W/O RELEASE



Comment: FINAL INSPECTION/W/O RELEASE

08/05/08 dg

Job Completion



mf 08-05-07

#4 1338726C
02221
07/05/2008
S.204 08.58
#1 403.4 F
#2 --- F
#3 30mm F
#4 --- F

W/O:		WORK ORDER CHANGES					
DATE	STEP	PROCEDURE CHANGE	By	Date	Qty	Approval Chief Eng / Prod Mgr	Approval QC Inspector



Part No: _____ PAR #: _____ Fault Category: _____ NCR: Yes No DQA: _____ Date: _____




QA: N/C Closed: _____ Date: _____

NCR:		WORK ORDER NON-CONFORMANCE (NCR)						
DATE	STEP	Description of NC Section A	Corrective Action Section B			Verification Section C	Approval Chief Eng	Approval QC Inspector
			Initial Chief Eng	Action Description Chief Eng	Sign & Date			

NOTE: Date & initial all entries

DART AEROSPACE LTD
HAWKESBURY, ONTARIO, CANADA

DESIGN	BW	DRAWN BY	PH	DART AEROSPACE LTD HAWKESBURY, ONTARIO, CANADA	
CHECKED		APPROVED		DRAWING NO.	REV. F
DATE	05.06.07			D2221	SHEET 2 OF 3
				TITLE	SCALE
				BASKET BASE ASSEMBLY (350)	1:20

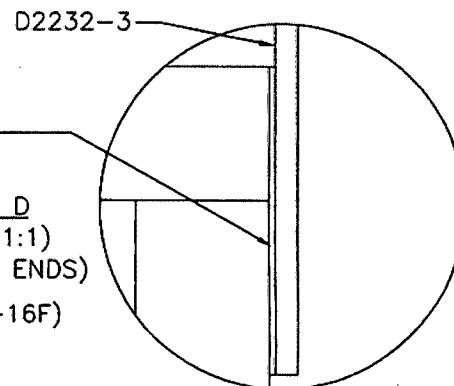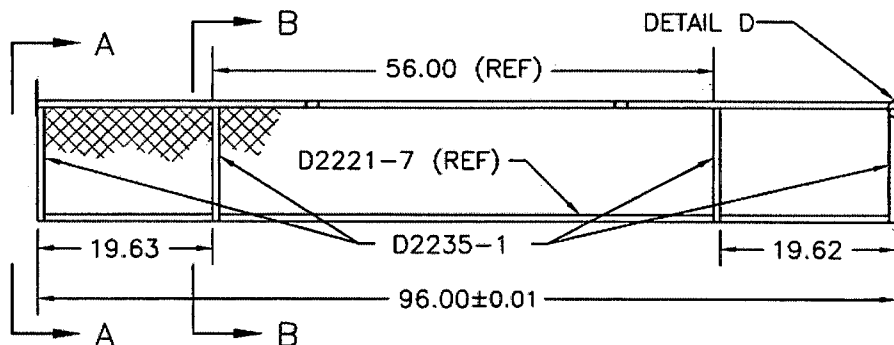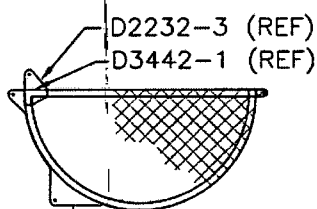

7
SU
D2325 (REF)

RELEASED

UNDER REVIEW

~~08-02-04~~
~~TUBING TO BE~~
~~CHANGED TO 0.063~~
~~INCH~~

Ref ^{WILL} 08.04.22

DETAIL D
(SCALE 1:1)
(TYP BOTH ENDS)

D2221 BASKET BASE ASSEMBLY


- 1) MESH MATERIAL: 3/4-16F EXPANDED SS (REF DART SPEC M304EX0.75-16F)
- 2) WELD PER DART QSI 004
- 3) TOLERANCES ARE PER DART QSI 018 UNLESS OTHERWISE NOTED
- 4) FINISH: POWDER COAT ENTIRE ASSEMBLY WHITE (4.3.5.2) PER DART QSI 005 4.3

THIS DOCUMENT IS PRIVATE AND CONFIDENTIAL AND IS SUPPLIED ON THE EXPRESS CONDITION THAT IT IS NOT TO BE USED FOR ANY PURPOSE OR COPIED OR COMMUNICATED TO ANY OTHER PERSON WITHOUT WRITTEN PERMISSION FROM DART AEROSPACE LTD.

Copyright © 1994 by DART AEROSPACE LTD

DART



DESIGN BW	DRAWN BY PH	DART AEROSPACE LTD HAWKESBURY, ONTARIO, CANADA	
CHECKED <i>[Signature]</i>	APPROVED <i>[Signature]</i>	DRAWING NO. D2221	REV. F SHEET 3 OF 3
DATE 05.06.07	TITLE BASKET BASE ASSEMBLY (350)		SCALE 1:8

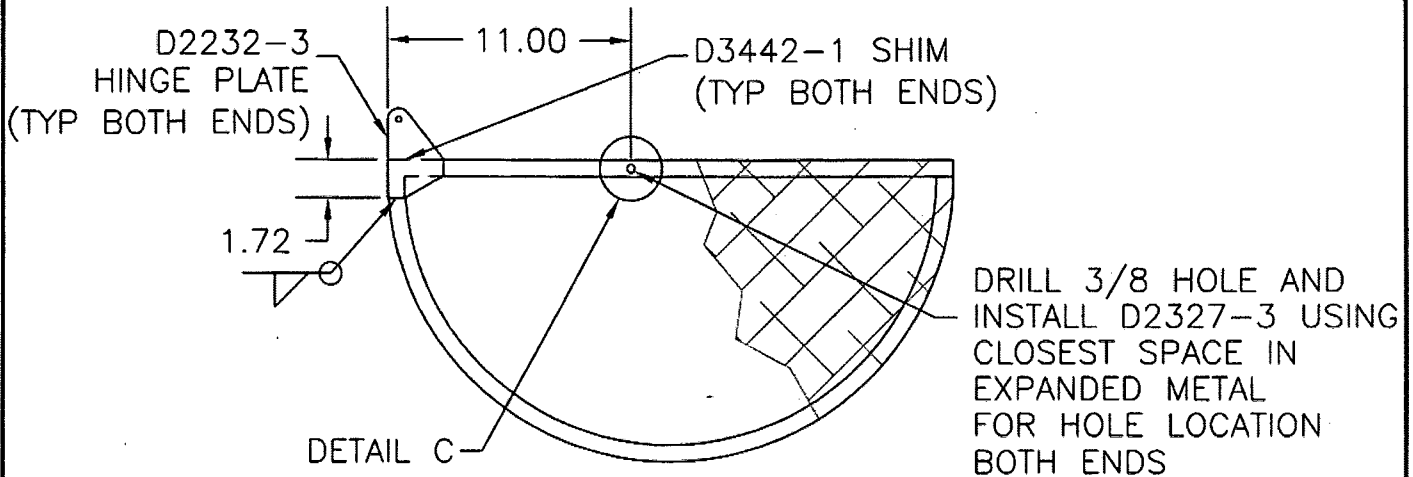

SECTION A-A SAME BOTH END RIBS

UNDER REVIEW
08.04.06 PH

TUBING TO BE
CHANGED TO 0.065
WALL
PH
01.04.02

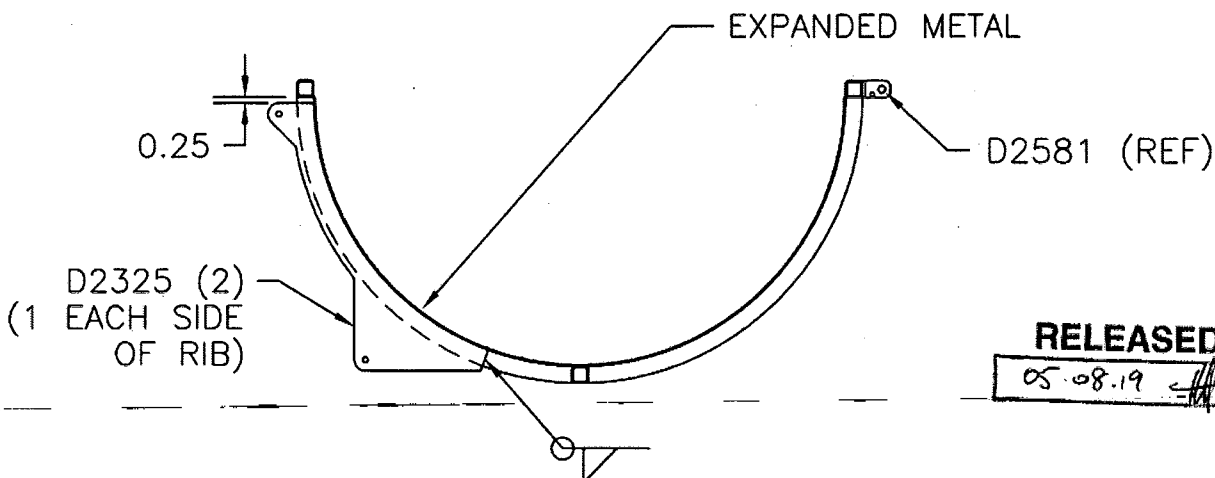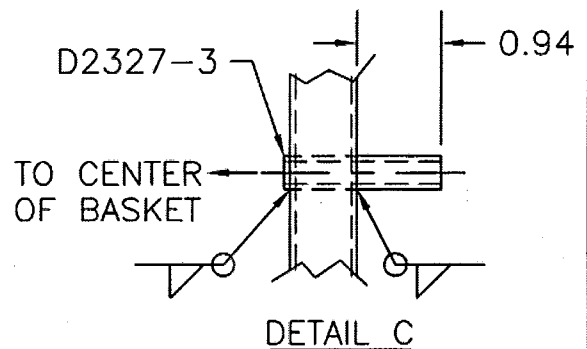

SECTION B-B SAME BOTH CENTER RIBS

RELEASED

05.08.19 *[Signature]*

SHOP COPY
RETURN TO
ENGINEERING

UNCONTROLLED COPY
SUBJECT TO AMENDMENT

WITHOUT NOTICE
WORK ORDER

NO. 38726C

Copyright © 1994 by DART AEROSPACE LTD



THIS DOCUMENT IS PRIVATE AND CONFIDENTIAL AND IS SUPPLIED ON THE EXPRESS CONDITION THAT IT IS NOT TO BE USED FOR ANY PURPOSE OR COPIED OR COMMUNICATED TO ANY OTHER PERSON WITHOUT WRITTEN PERMISSION FROM DART AEROSPACE LTD.



DESIGN B WILLIAMS	DRAWN BY B WILLIAMS	DART AEROSPACE LTD VICTORIA INTERNATIONAL AIRPORT, CANADA	
CHECKED <i>[Signature]</i>	APPROVED <i>[Signature]</i>	DRAWING NO. D2235	REV. 8 SHEET 1 OF 1
DATE 94:12:16		TITLE BASKET RIBS	

BI	02.08.06 A-1	CAN BE MADE FROM D3166-1
----	--------------	--------------------------

RELEASED
R 960507

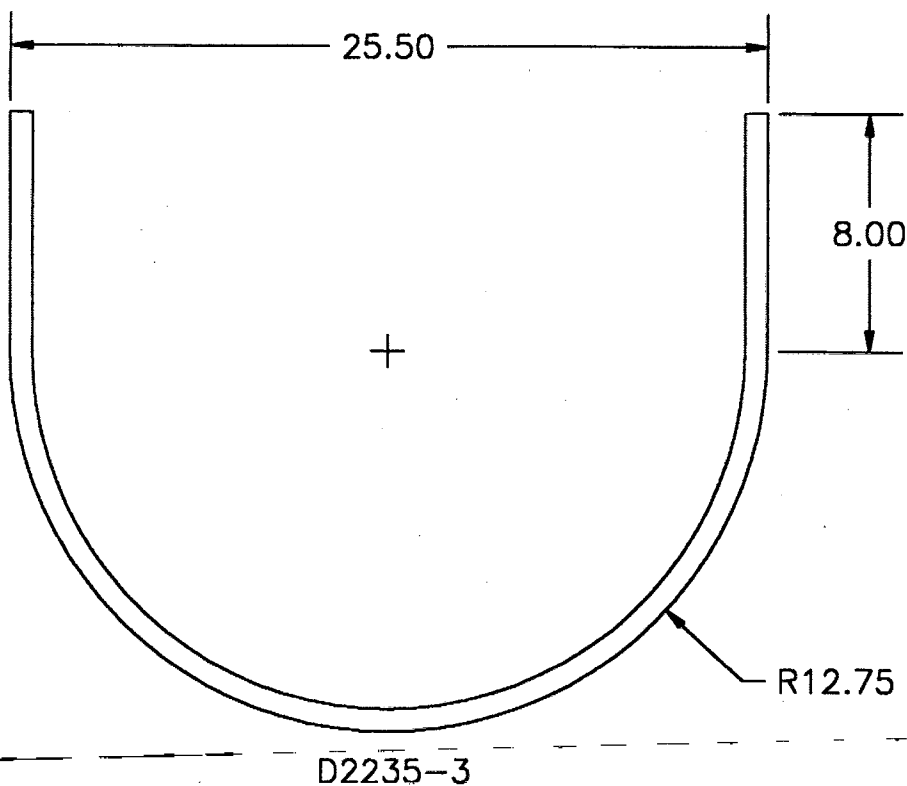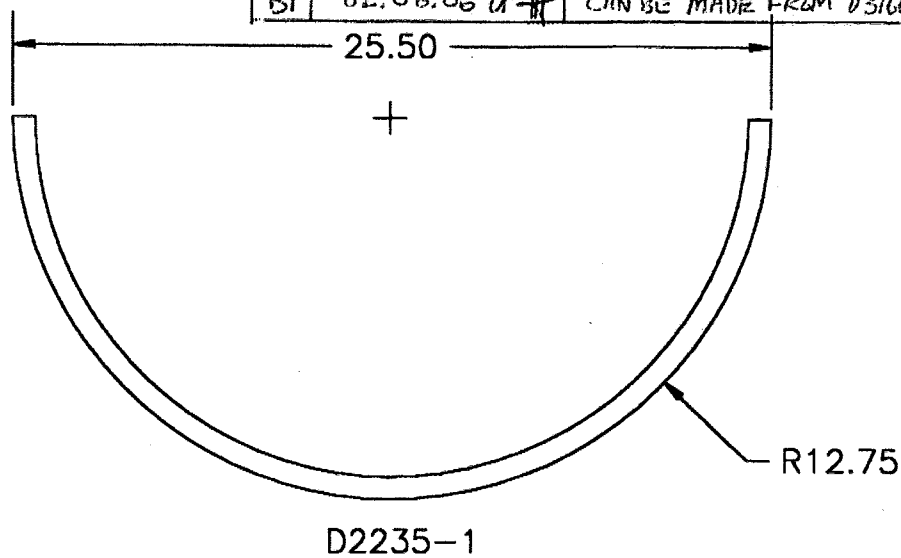

CAN BE MADE FROM D3166-1 \triangle BI
MATERIAL: 304/316 SS, 3/4 X 3/4 X 0.063 WALL SQR.

SHOP COPY
RETURN TO
ENGINEERING
UNCONTROLLED COPY
SUBJECT TO AMENDMENT
WITHOUT NOTICE
WORK ORDER
NO. 32726

Date: Tuesday, 22/04/2008 10:32:24 AM
 User: Julie Lecocq

Process Sheet

Customer : CU-DAR001 Dart Helicopters Services	Drawing Name : BASKET LID ASSEMBLY
Job Number : 38726A	
Estimate Number : 10206	
P.O. Number :	Part Number : D2989041
This Issue : 22/04/2008 S.O. No. :	Drawing Number : D2989 UNDER REVIEW
Prsht Rev. : NC	Project Number : N/A <i>08.04.22</i>
First Issue : / / Type : LARGE FAB ASSY	Drawing Revision : B
Previous Run : 38725A	Material :
Written By :	Due Date : 10/05/2008 Qty: 1 Um: Each
Checked & Approved By : <i>JLD 08.4.22</i>	
Comment : Est Rev: Removed D2989-043 05-11-03 JLM	

Additional Product

Job Number:



Seq. #:	Machine Or Operation:	Description :
----------------	------------------------------	----------------------

1.0	D31663	Basket Hoop
-----	--------	-------------



Comment: Qty.: 1.0000 Each(s)/Unit Total : 1.0000 Each(s)

Pick:

Qty.(1) D3166-3

Batch: *1737612*

✓ *FC 08 05 06*

2.0	D2581	Mounting Bracket
-----	-------	------------------



Comment: Qty.: 2.0000 Each(s)/Unit Total : 2.0000 Each(s)

Pick:

Qty Part number

Description Batch

2 D2581

Mounting Brackets

1737248

✓ *FC 08 05 06*

3.0	D23273	Spacer Bushing
-----	--------	----------------



Comment: Qty.: 2.0000 Each(s)/Unit Total : 2.0000 Each(s)

Pick:

Qty Part number

Description Batch

2 D2327-3

Bushing

1737851

✓ *FC 08 05 06*

4.0	D2506	Label Plate
-----	-------	-------------



Comment: Qty.: 1.0000 Each(s)/Unit Total : 1.0000 Each(s)

Pick:

Qty Part number

Description Batch

1 D2506

Label Plate

1735585

✓ *FC 08 05 06*

W/O:		WORK ORDER CHANGES					
DATE	STEP	PROCEDURE CHANGE	By	Date	Qty	Approval Chief Eng / Prod Mgr	Approval QC Inspector

Part No: _____ PAR #: _____ Fault Category: _____ NCR: Yes No DQA: _____ Date: _____

QA: N/C Closed: _____ Date: _____

NCR:		WORK ORDER NON-CONFORMANCE (NCR)						
DATE	STEP	Description of NC Section A	Corrective Action Section B			Verification Section C	Approval Chief Eng	Approval QC Inspector
			Initial Chief Eng	Action Description Chief Eng	Sign & Date			

NOTE: Date & initial all entries

Date: Tuesday, 22/04/2008 10:32:24 AM
User: Julie Lecocq

Process Sheet

Customer: CU-DAR001 Dart Helicopters Services

Drawing Name: BASKET-LID ASSEMBLY

Job Number: 38726A

Part Number: D2989041

Job Number:



Seq. #:

Machine Or Operation:

Description :

5.0

M304EX07516F

Expanded Metal Flat Stai



Comment: Qty.: 15.0000 sf(s)/Unit Total: 15.0000 sf(s)
Pick:

Qty Part number Description Batch
15sf M304EX0.75-16F Expanded Metal

M107316

FC 08 05 06

6.0

M304TS0750W065

304 SQ Tube.75x.75x.065W



Comment: Qty.: 31.7709 f(s)/Unit Total: 31.7709 f(s)
3/4" x 3/4" x 0.065" wall 304/316 SS tubing.

Batch: M107515

SAD 28/05/06

7.0

LARGE FAB 1

LARGE FABRICATION RESOURCE 1



Comment: LARGE FABRICATION RESOURCE 1

1-Cut (4) D2236-1 From D3166-3 As Per Dwg D2989 FC

2-Drill holes in tubing as D2989-041 per Dwg D2989 FC

3-Deburr and remove all markings on material FC

4-Weld as per Dwg D2989 and D2989-041 Assembly using Welding Table and corner Jig. Deburr as required

Note: Expanded metal "diamonds" must run lengthwise. Eg 2.0" along length of lid FC

5-Drill Ø0.257" hole as D2989-041 per Dwg D2989 Identify as D2989-041

FC 08/05/06

8.0

QC9

VISUAL WELDING INSPECTION



Comment: VISUAL WELDING INSPECTION

9.0

QC5

INSPECT WORK TO CURRENT STEP



Comment: INSPECT WORK TO CURRENT STEP

10.0

POWDER COATING

POWDER COATING



Comment: POWDER COATING

1-Powder Coat White (Ref. 4.3.5.2) D2989-041 as per QSI 005 4.3 & Dwg D2989

3 38726A
D2989041

07/05/2008

S.199 08/52

#1 405.5 F

#2 - - F

#3 30 min F

#4 - - F

W/O:		WORK ORDER CHANGES					
DATE	STEP	PROCEDURE CHANGE	By	Date	Qty	Approval Chief Eng / Prod Mgr	Approval QC Inspector

Part No: _____ PAR #: _____ Fault Category: _____ NCR: Yes No DQA: _____ Date: _____

QA: N/C Closed: _____ Date: _____

NCR:		WORK ORDER NON-CONFORMANCE (NCR)						
DATE	STEP	Description of NC Section A	Corrective Action Section B			Verification Section C	Approval Chief Eng	Approval QC Inspector
			Initial Chief Eng	Action Description Chief Eng	Sign & Date			

NOTE: Date & initial all entries

Date: Tuesday, 22/04/2008 10:32:24 AM
User: Julie Lecocq

Process Sheet

Customer: CU-DAR001 Dart Helicopters Services Drawing Name: BASKET LID ASSEMBLY

Job Number: 38726A

Part Number: D2989041

Job Number:



Seq. #:

Machine Or Operation:

Description :

2-Wing walk D2989-041 as per Dwg D2989 and QSI 005 4.4

Spray Paint Black: M107603

Wing Walk: M107380

M-f 08/05/07 (12)

11.0

QC3

INSPECT POWDER COAT/CHEMICAL CONVERSION



Comment: Inspect Powder Coat and Wing Walk

BL 08-05-07

12.0

QC21

FINAL INSPECTION/W/O RELEASE



Comment: FINAL INSPECTION/W/O RELEASE

08/05/08

Job Completion



mf 08-05-09

W/O:		WORK ORDER CHANGES					
DATE	STEP	PROCEDURE CHANGE	By	Date	Qty	Approval Chief Eng / Prod Mgr	Approval QC Inspector

Part No: _____ PAR #: _____ Fault Category: _____ NCR: Yes No DQA: _____ Date: _____

QA: N/C Closed: _____ Date: _____

NCR:		WORK ORDER NON-CONFORMANCE (NCR)						
DATE	STEP	Description of NC Section A	Corrective Action Section B			Verification Section C	Approval Chief Eng	Approval QC Inspector
			Initial Chief Eng	Action Description Chief Eng	Sign & Date			

NOTE: Date & initial all entries



DESIGN DS	DRAWN BY PH	DART AEROSPACE LTD HAWKESBURY, ONTARIO, CANADA	
CHECKED <i>[Signature]</i>	APPROVED <i>[Signature]</i>	DRAWING NO. D2989	REV. B SHEET 1 OF 3
DATE 05.06.07		TITLE BASKET LID ASSEMBLY	SCALE NTS
A	00.10.27	NEW ISSUE	
B	05.06.07	ADD SHIM UNDER HINGES, UPDATE LID DIMENSIONS	

RELEASED

05-08-19 *[Signature]*

PARTS LIST:

Qty -041	Qty -043	Part Number	Description
X		D2989-041	BASKET LID ASSEMBLY (OUTSIDE)
	X	D2989-043	BASKET LID ASSEMBLY (INSIDE)
	1	D2989-1	STRUT
	1	D2989-2	STRUT
	1	D2989-3	STRUT
	1	D2989-4	STRUT
	2	D2989-5	STRUT
	2	D2989-7	STRUT
1		D2989-9	STRUT
1		D2989-10	STRUT
1		D2989-11	STRUT
1		D2989-12	STRUT
2		D2989-13	STRUT
2		D2989-15	STRUT
2		D2327-3	SPACER BUSHING
1		D2506	LABEL PLATE
2	2	D2989-17	STRUT (96.00" LONG)
2		D2989-19	STRUT (31.19" LONG)
1		D2512-7	STRUT
2		D2581	MOUNTING BRACKET
	2	D3182-1	HINGE
	2	D3442-3	SHIM

UNDER REVIEW

08.02.05 *[Signature]*
TUBING TO BE
CHANGED TO 0.065
WALL *[Signature]*

08.04.22

SHOP COPY
RETURN TO
ENGINEERING

UNCONTROLLED COPY

SUBJECT TO AMENDMENT

WITHOUT NOTICE

WORK ORDER


NO. 38726A



NOTES:

- 1) FRAME MATERIAL: AISI 304/316 SS, 3/4 x 3/4 x ~~0.060~~ ^{0.055} WALL SQUARE TUBING
D2989-3/4/5/11/12/13 CAN BE MADE FROM D2236
- 2) MESH MATERIAL: 3/4-16F EXPANDED SS (REF DART SPEC M304EX0.75-16F)
- 3) WELD PER DART QSI 004
- 4) FINISH: POWDER COAT WHITE (REF 4.3.5.2) PER DART QSI 005 4.3.
BLACK ANTI-SKID PAINT AS INDICATED PER DART QSI 005 4.4. SPRAY PAINT
INSIDE SURFACE BLACK PRIOR TO APPLYING ANTI-SKID.
- 5) ALL DIMENSIONS ARE IN INCHES
- 5) TOLERANCES ARE PER DART QSI 018 UNLESS OTHERWISE NOTED

Copyright © 2000 by DART AEROSPACE LTD



THIS DOCUMENT IS PRIVATE AND CONFIDENTIAL AND IS SUPPLIED ON THE EXPRESS CONDITION THAT IT IS NOT TO BE USED FOR ANY PURPOSE OR COPIED OR COMMUNICATED TO ANY OTHER PERSON WITHOUT WRITTEN PERMISSION FROM DART AEROSPACE LTD.

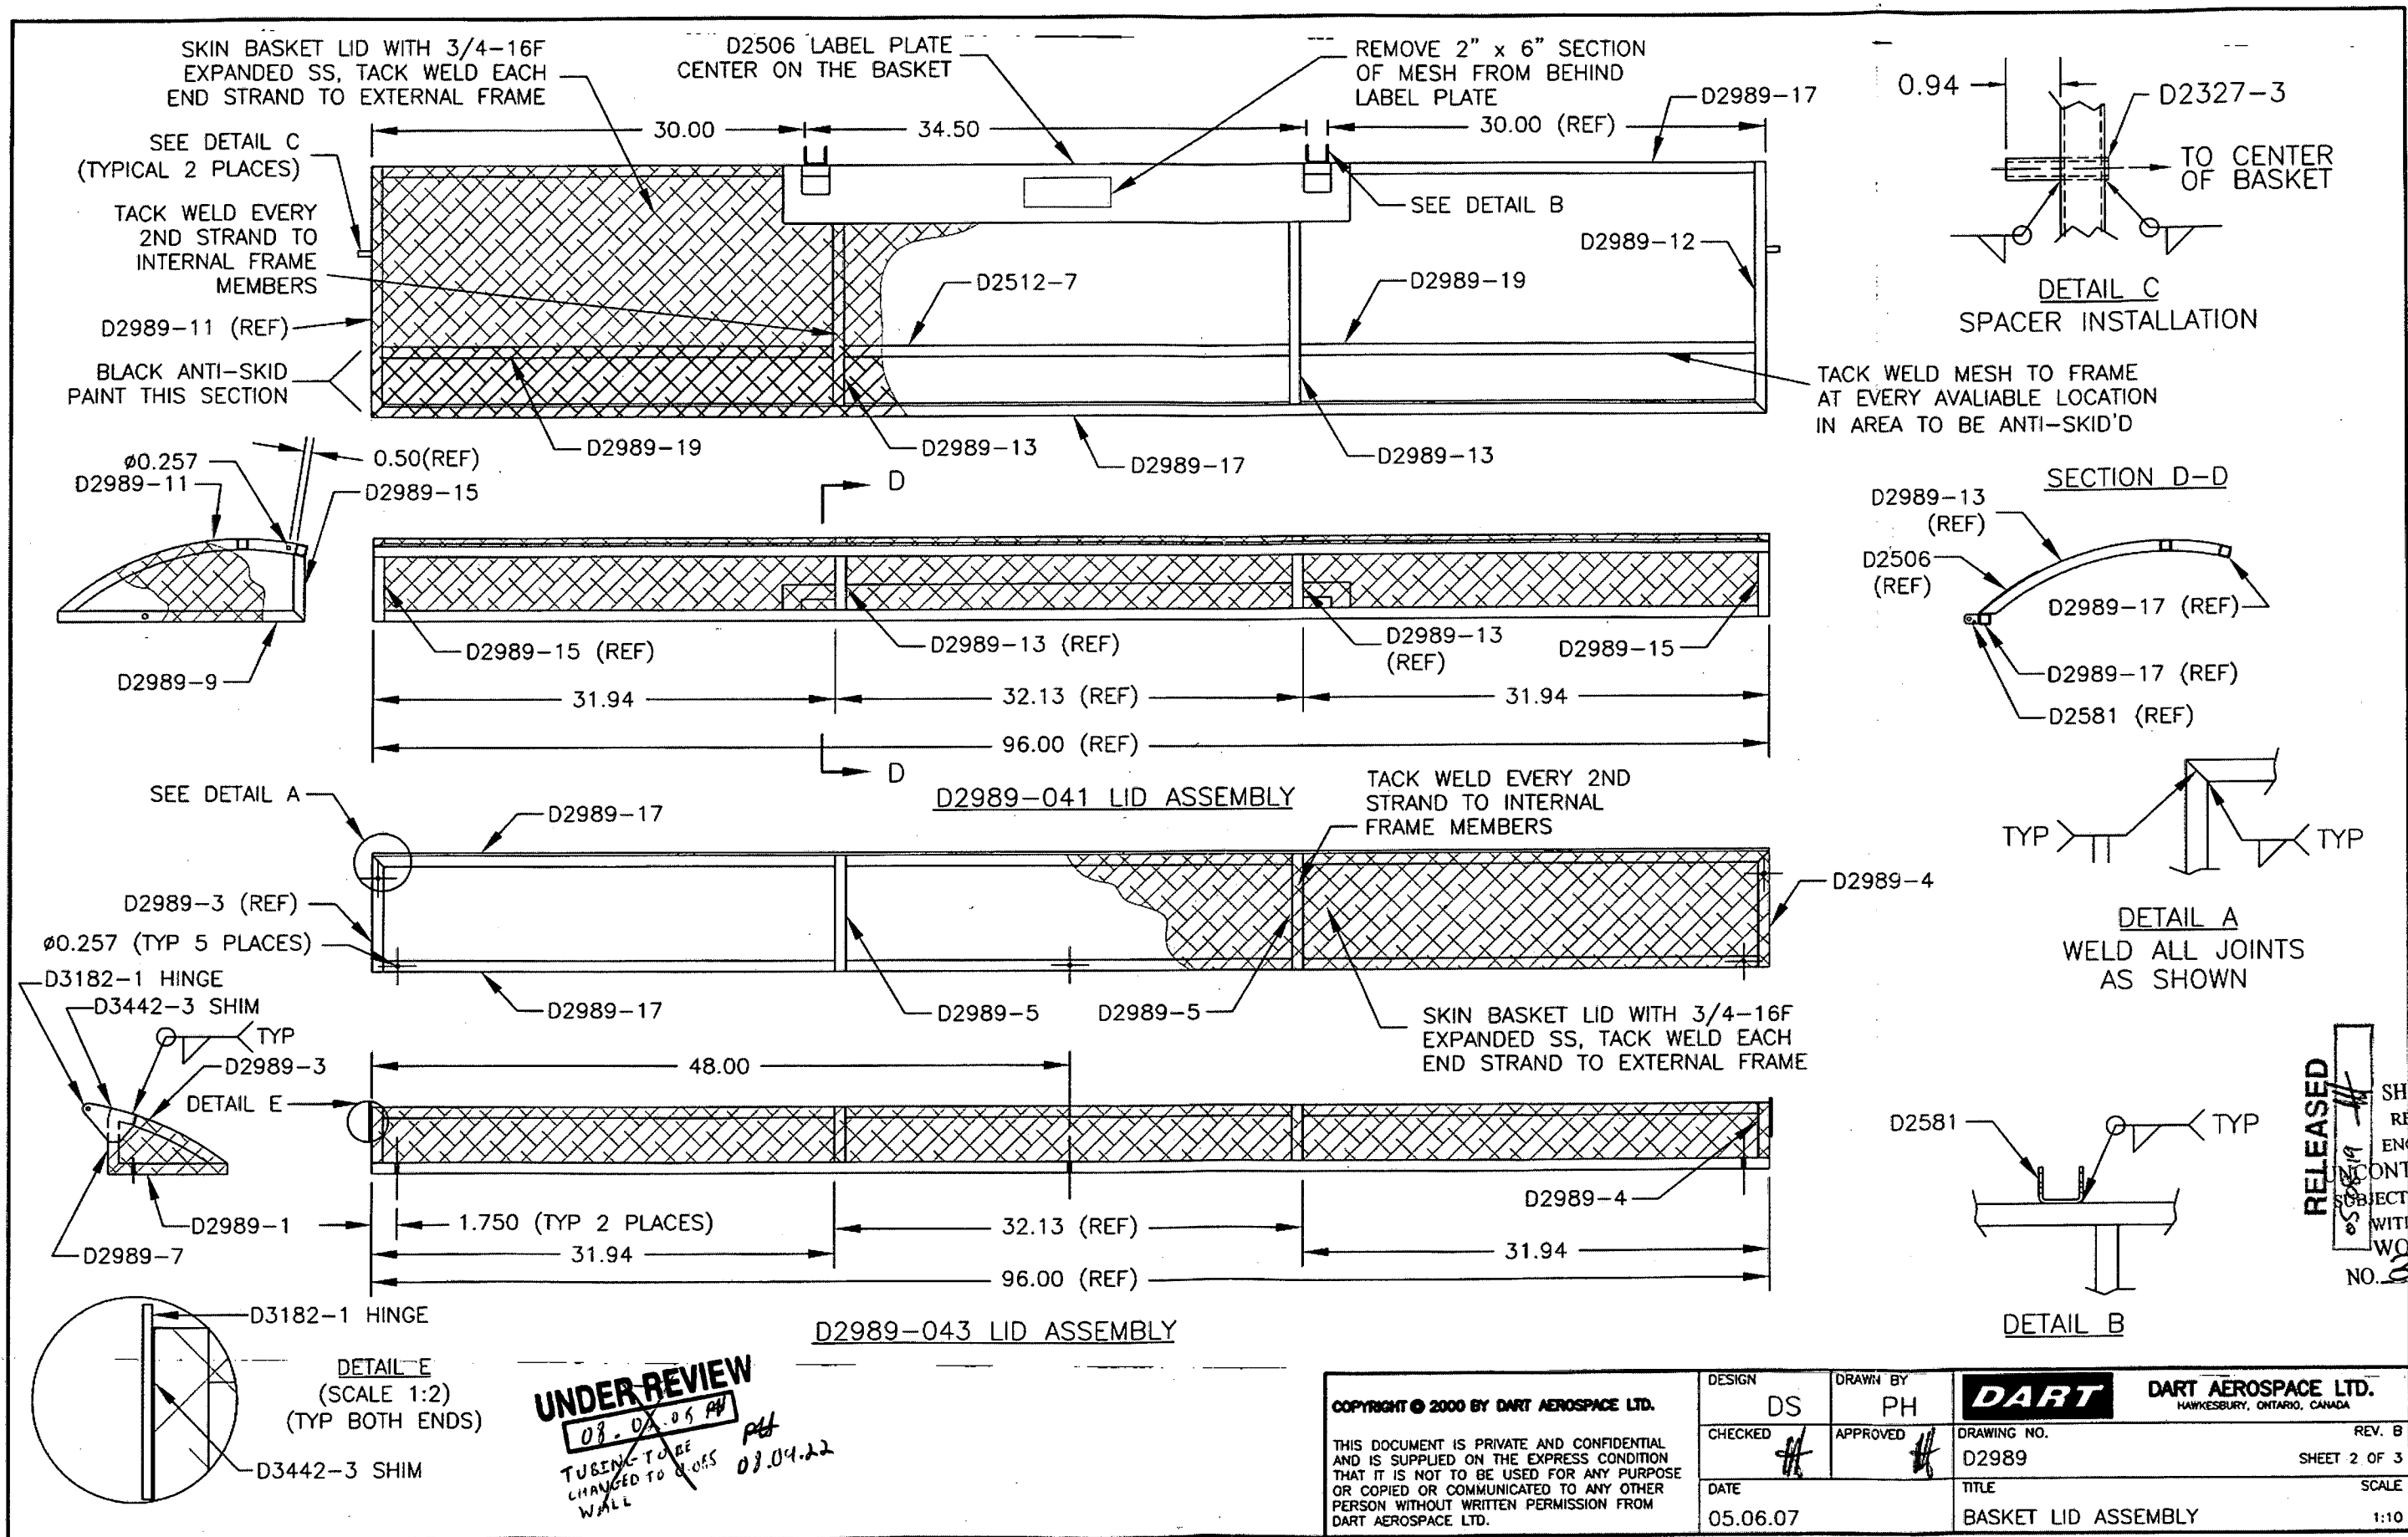

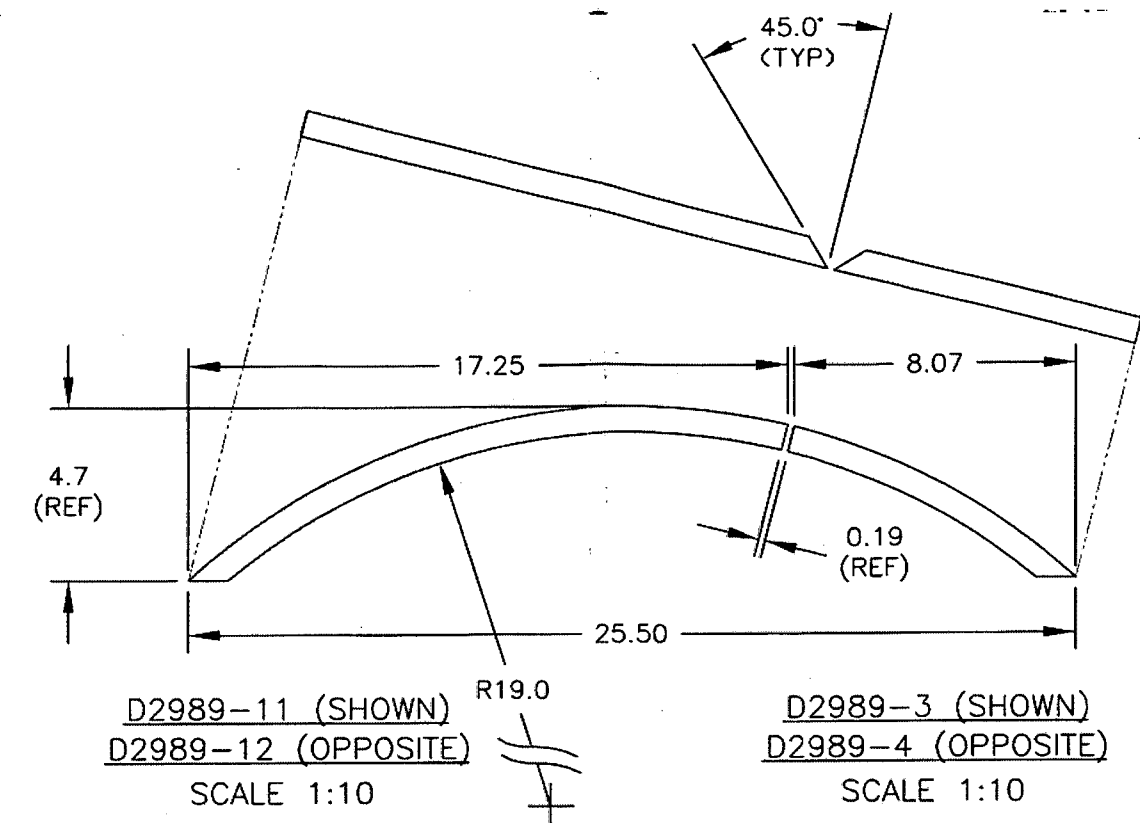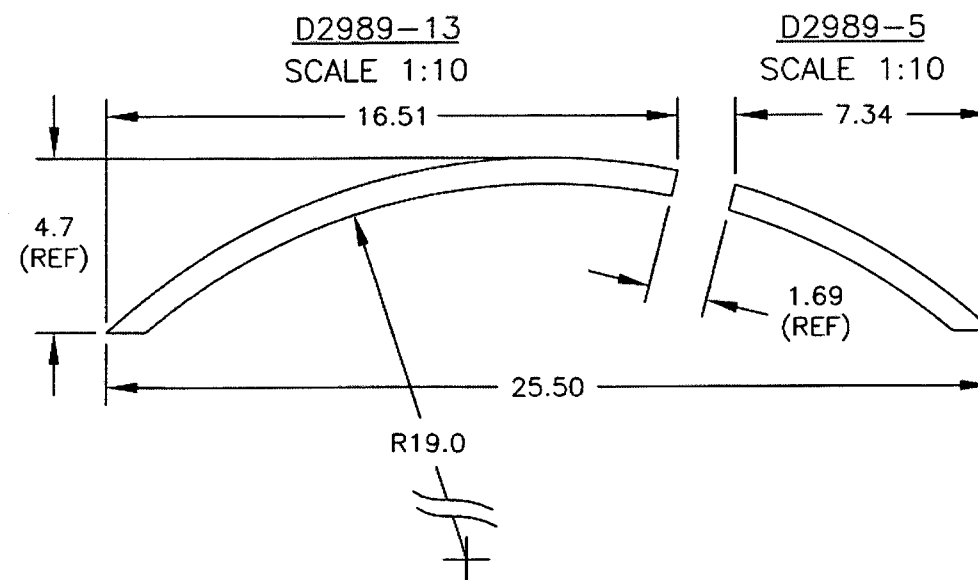



D2989-15
SCALE 2:5
(DIMENSIONS LISTED AS REFERENCE ONLY, CUT TO FIT ASSEMBLY)

D2989-7
SCALE 2:5
(DIMENSIONS LISTED AS REFERENCE ONLY, CUT TO FIT ASSEMBLY)

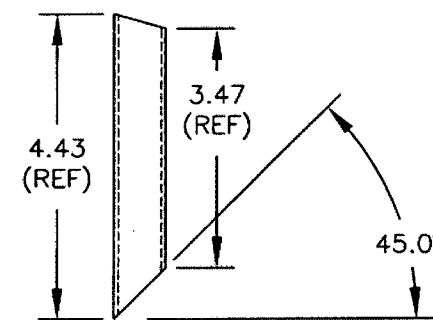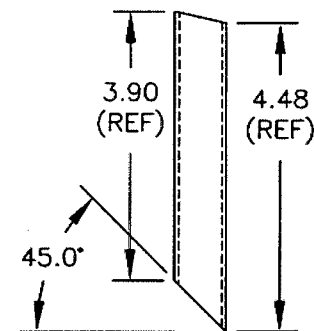

D2989-9 (SHOWN)
D2989-10 (SIMILAR)
SCALE 2:5

THIS END OPPOSITE FOR D2989-10

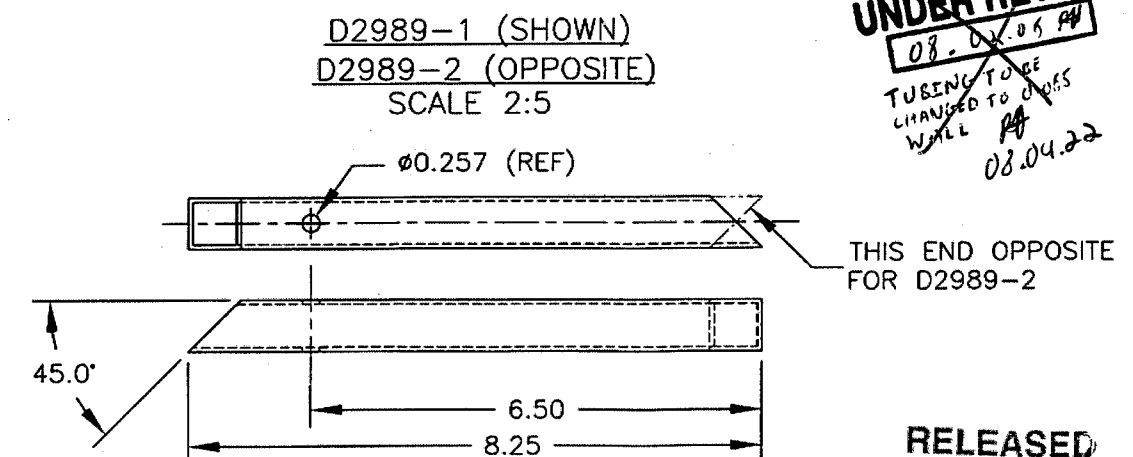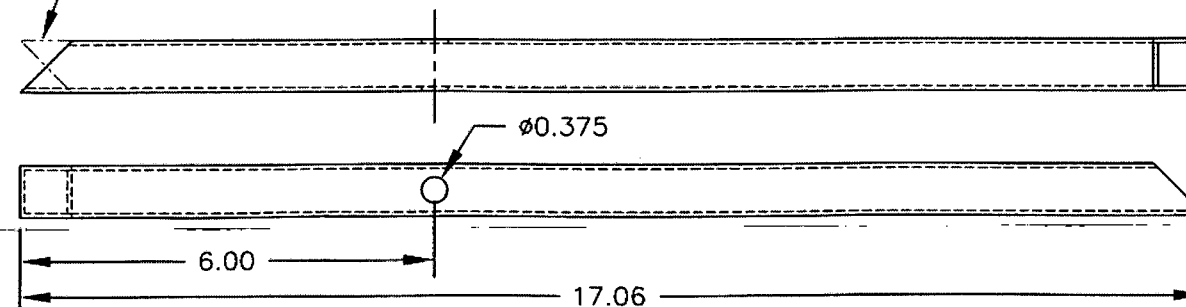

UNDER REVIEW
08.04.05 PH
TUBING TO BE
CHANGED TO Ø0.65
WALL PH
08.04.22

COPYRIGHT © 2000 BY DART AEROSPACE LTD.

THIS DOCUMENT IS PRIVATE AND CONFIDENTIAL AND IS SUPPLIED ON THE EXPRESS CONDITION THAT IT IS NOT TO BE USED FOR ANY PURPOSE OR COPIED OR COMMUNICATED TO ANY OTHER PERSON WITHOUT WRITTEN PERMISSION FROM DART AEROSPACE LTD.

DESIGN DS	DRAWN BY PH	DART	DART AEROSPACE LTD. HAWKESBURY, ONTARIO, CANADA
CHECKED PH	APPROVED PH	DRAWING NO. D2989	REV. B SHEET 3 OF 3
DATE 05.06.07	TITLE BASKET LID ASSEMBLY	SCALE 1:10	

SHOP COPY
RETURN TO
ENGINEERING
UNCONTROLLED COPY
SUBJECT TO AMENDMENT
WITHOUT NOTICE
WORK ORDER
NO 3872611

Date: Tuesday, 22/04/2008 10:32:28 AM
 User: Julie Lecocq

Process Sheet

Customer : CU-DAR001 Dart Helicopters Services	Drawing Name : BASKET LID ASSEMBLY
Job Number : 38726B	
Estimate Number : 10207	
P.O. Number :	Part Number : D2989043
This Issue : 22/04/2008 S.O. No. :	Drawing Number : D2989 UNDER REVIEW
Prsht Rev. : NC	Project Number : N/A <i>03.04.22</i>
First Issue : // Type : LARGE FAB ASSY	Drawing Revision : B
Previous Run : 38725B	Material :
Written By :	Due Date : 10/05/2008 Qty: 1 Um: Each
Checked & Approved By : <i>JLD 08.4.22</i>	
Comment : Est Rev:l Removed D2989-041 05-11-03 JLM	

Additional Product

Job Number:



Seq. #:	Machine Or Operation:	Description :
----------------	------------------------------	----------------------

1.0	D31821	Hinge
-----	--------	-------



Comment: Qty.: 2.0000 Each(s)/Unit Total : 2.0000 Each(s)

Pick:

Qty Part number	Description	Batch
2 D3182-1	Hinge	<i>536483</i>

✓ FC 08 05 06

2.0	D34423	Shim
-----	--------	------



Comment: Qty.: 2.0000 Each(s)/Unit Total : 2.0000 Each(s)

Pick:

Qty Part number	Description	Batch
2 D3442-3	Shim	<i>537160</i>

✓ FC 08 05 06

3.0	M304EX07516F	Expanded Metal Flat Stai
-----	--------------	--------------------------



Comment: Qty.: 8.0000 sf(s)/Unit Total : 8.0000 sf(s)

Pick:

Qty Part number	Description	Batch
8sf M304EX0.75-16F Expanded Metal		<i>M107316</i>

✓ FC 08 05 06

4.0	M304TS0750W065	304 SQ Tube.75x.75x.065W
-----	----------------	--------------------------



Comment: Qty.: 17.6400 f(s)/Unit Total : 17.6400 f(s)

3/4" x 3/4" x 0.065" wall 304/316 SStubing.

Batch: *M107515*

SAD 02/04/30 ①

Dart Aerospace Ltd

W/O:		WORK ORDER CHANGES					
DATE	STEP	PROCEDURE CHANGE	By	Date	Qty	Approval Chief Eng / Prod Mgr	Approval QC Inspector

Part No: _____ PAR #: _____ Fault Category: _____ NCR: Yes No DQA: _____ Date: _____

QA: N/C Closed: _____ Date: _____

NCR:		WORK ORDER NON-CONFORMANCE (NCR)						
DATE	STEP	Description of NC Section A	Corrective Action Section B			Verification Section C	Approval Chief Eng	Approval QC Inspector
			Initial Chief Eng	Action Description Chief Eng	Sign & Date			

NOTE: Date & initial all entries

Date: Tuesday, 22/04/2008 10:32:28 AM
User: Julie Lecocq

Process Sheet

Customer: CU-DAR001 Dart Helicopters Services Drawing Name: BASKET LID ASSEMBLY

Job Number: 38726B

Part Number: D2989043

Job Number:



Seq. #:

Machine Or Operation:

Description :

5.0

LARGE FAB 1

LARGE FABRICATION RESOURCE 1



Comment: LARGE FABRICATION RESOURCE 1

1-Cut (4) D2236-1 From D3166-3 As Per Dwg D2989

Note: D2989-3/-4 On -041 Bom

SAD 08/05/09

①

2-Drill holes in tubing as D2989-043 per Dwg D2989

FL

3-Deburr and remove all markings on material

FL

4-Weld as per Dwg D2989 and D2989-043 Assembly using Welding Table and corner Jig. Deburr as required

Note: Expanded metal "diamonds" must run lengthwise. Eg 2.0" along length of lid

FL 08 05 06 ①

6.0

QC9

VISUAL WELDING INSPECTION



Comment: VISUAL WELDING INSPECTION

08/05/06

7.0

QC6

DIMENSIONAL CHECK



Comment: DIMENSIONAL CHECK

08/05/06

8.0

POWDER COATING

POWDER COATING



Comment: POWDER COATING

1-Powder Coat White (Ref. 4.3.5.2) D2989-041 as per QSI 005 4.3 & Dwg D2989

M107550

133672613

D2989043

07/05/2008

S.200 08.57

#1 402.7 F

#2 3000 F

08-05-07

9.0

QC3

INSPECT POWDER COAT/CHEMICAL CONVERSION



Comment: Inspect Powder Coat

m/f

08/05/07

(X)

10.0

QC21

FINAL INSPECTION/W/O RELEASE



Comment: FINAL INSPECTION/W/O RELEASE

08/05/08

Job Completion



mf 08-05-07

Dart Aerospace Ltd

W/O:		WORK ORDER CHANGES					
DATE	STEP	PROCEDURE CHANGE	By	Date	Qty	Approval Chief Eng / Prod Mgr	Approval QC Inspector

Part No: _____ PAR #: _____ Fault Category: _____ NCR: Yes No DQA: _____ Date: _____

QA: N/C Closed: _____ Date: _____

NCR:		WORK ORDER NON-CONFORMANCE (NCR)						
DATE	STEP	Description of NC Section A	Corrective Action Section B			Verification Section C	Approval Chief Eng	Approval QC Inspector
			Initial Chief Eng	Action Description Chief Eng	Sign & Date			

NOTE: Date & initial all entries



DESIGN DS	DRAWN BY PH	DART AEROSPACE LTD HAWKESBURY, ONTARIO, CANADA	
CHECKED <i>[Signature]</i>	APPROVED <i>[Signature]</i>	DRAWING NO. D2989	REV. B SHEET 1 OF 3
DATE 05.06.07		TITLE BASKET LID ASSEMBLY	SCALE NTS
A	00.10.27	NEW ISSUE	
B	05.06.07	ADD SHIM UNDER HINGES, UPDATE LID DIMENSIONS	

RELEASED

05-08-19 *[Signature]*

PARTS LIST:

Qty -041	Qty -043	Part Number	Description
X		D2989-041	BASKET LID ASSEMBLY (OUTSIDE)
	X	D2989-043	BASKET LID ASSEMBLY (INSIDE)
	1	D2989-1	STRUT
	1	D2989-2	STRUT
	1	D2989-3	STRUT
	1	D2989-4	STRUT
	2	D2989-5	STRUT
	2	D2989-7	STRUT
1		D2989-9	STRUT
1		D2989-10	STRUT
1		D2989-11	STRUT
1		D2989-12	STRUT
2		D2989-13	STRUT
2		D2989-15	STRUT
2		D2327-3	SPACER BUSHING
1		D2506	LABEL PLATE
2	2	D2989-17	STRUT (96.00" LONG)
2		D2989-19	STRUT (31.19" LONG)
1		D2512-7	STRUT
2		D2581	MOUNTING BRACKET
	2	D3182-1	HINGE
	2	D3442-3	SHIM

UNDER REVIEW
08.02.05 *[Signature]*

TUBING TO BE
CHANGED TO 0.065
WALL

SHOP COPY
RETURN TO
ENGINEERING

UNCONTROLLED COPY
SUBJECT TO AMENDMENT







WITHOUT NOTICE
WORK ORDER

NOTES:

- 1) FRAME MATERIAL: AISI 304/316 SS, 3/4 x 3/4 x 0.065 WALL SQUARE TUBING NO. *0.065 01.04.22*
D2989-3/4/5/11/12/13 CAN BE MADE FROM D2236
- 2) MESH MATERIAL: 3/4-16F EXPANDED SS (REF DART SPEC M304EX0.75-16F)
- 3) WELD PER DART QSI 004
- 4) FINISH: POWDER COAT WHITE (REF. 4.3.5.2) PER DART QSI 005 4.3.
BLACK ANTI-SKID PAINT AS INDICATED PER DART QSI 005 4.4. SPRAY PAINT
INSIDE SURFACE BLACK PRIOR TO APPLYING ANTI-SKID.
- 5) ALL DIMENSIONS ARE IN INCHES
- 5) TOLERANCES ARE PER DART QSI 018 UNLESS OTHERWISE NOTED

Copyright © 2000 by DART AEROSPACE LTD

THIS DOCUMENT IS PRIVATE AND CONFIDENTIAL AND IS SUPPLIED ON THE EXPRESS CONDITION THAT IT IS NOT TO BE USED FOR ANY PURPOSE OR COPIED OR COMMUNICATED TO ANY OTHER PERSON WITHOUT WRITTEN PERMISSION FROM DART AEROSPACE LTD.

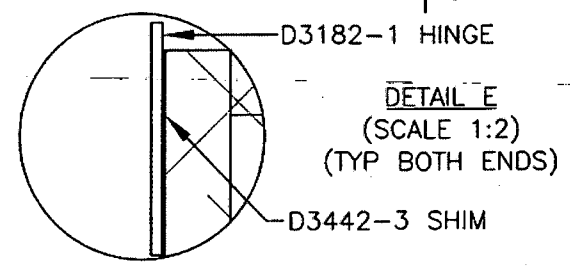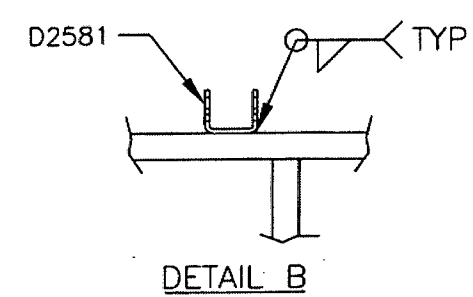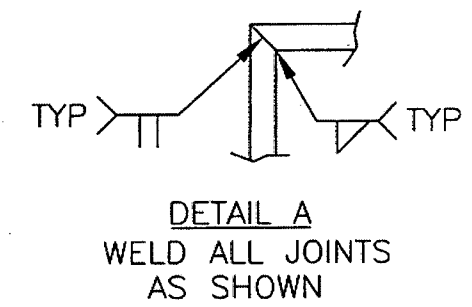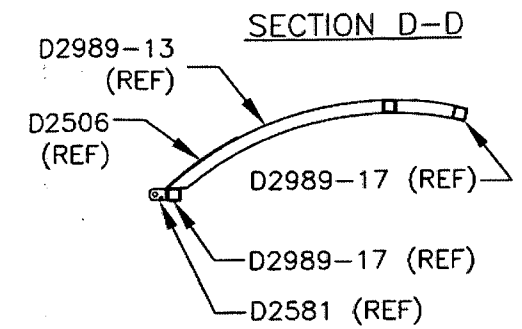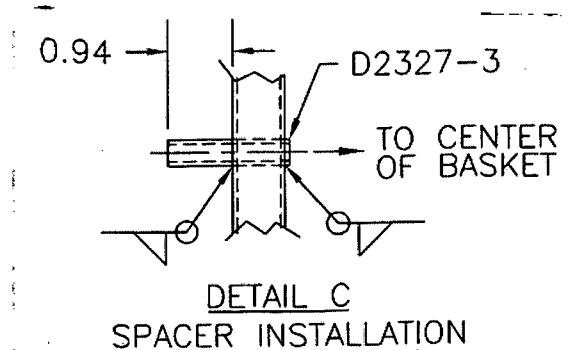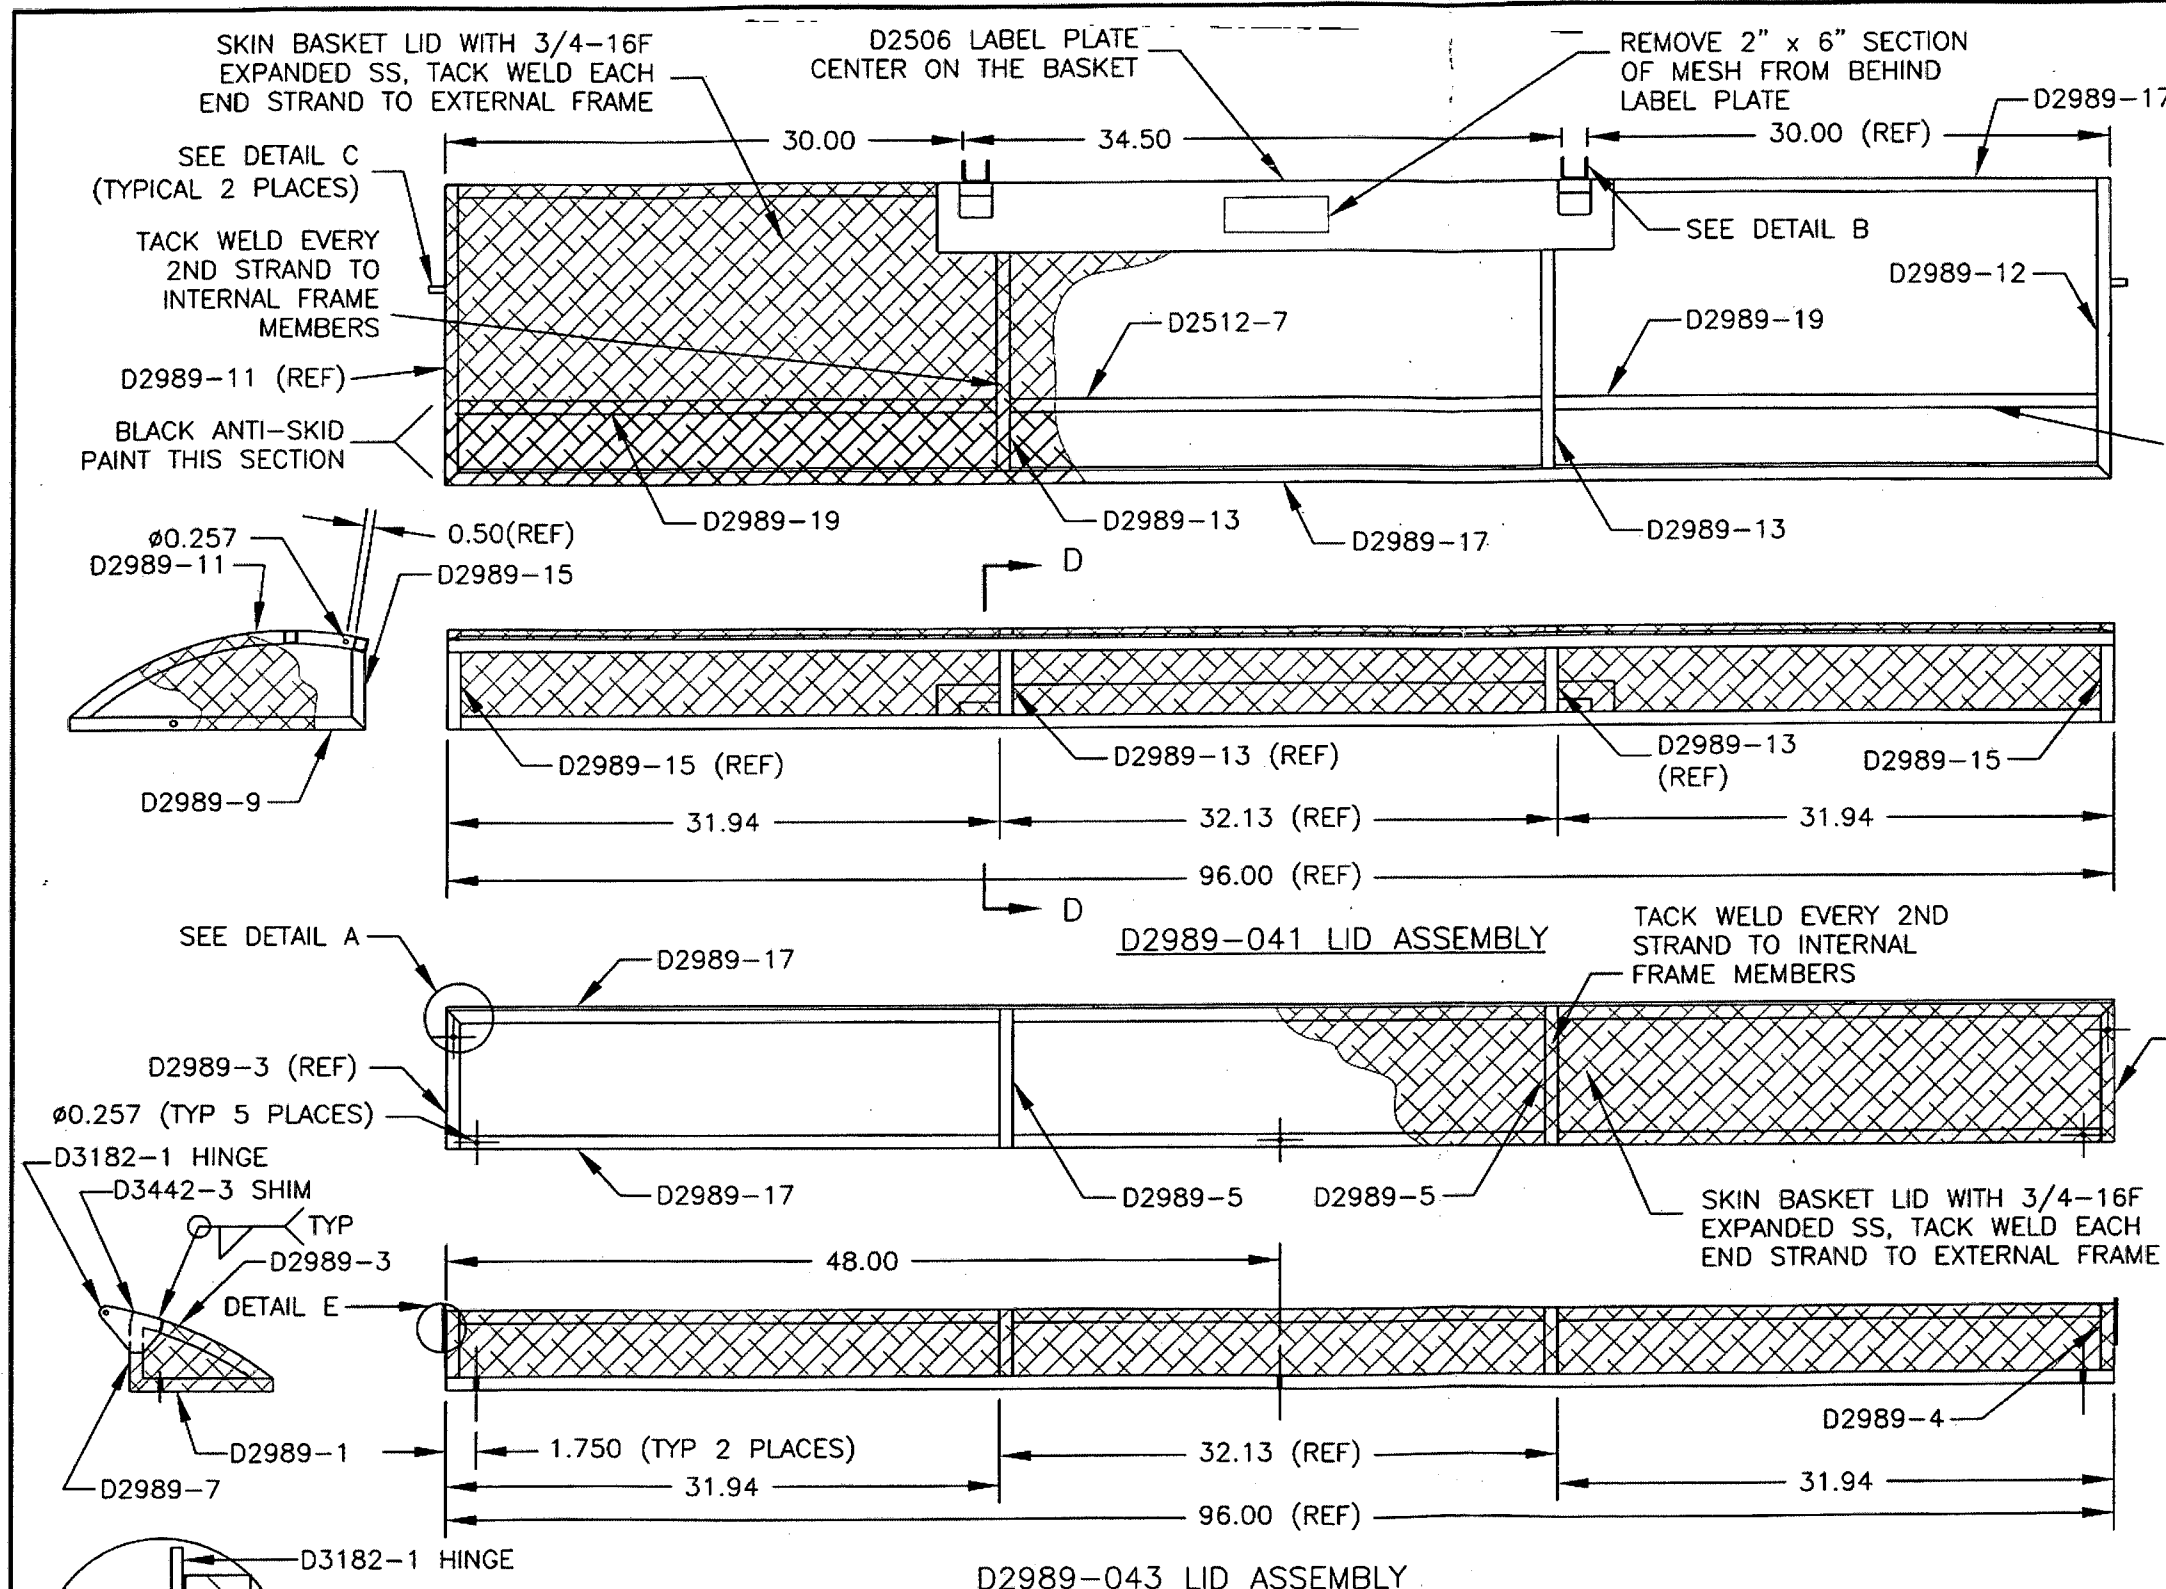

UNDER REVIEW

08.02.05 PH

TUBING TO BE CHANGED TO 0.065 WALL



07.04.02

COPYRIGHT © 2000 BY DART AEROSPACE LTD.		DESIGN	DRAWN BY	DART DART AEROSPACE LTD. HAWKESBURY, ONTARIO, CANADA	
THIS DOCUMENT IS PRIVATE AND CONFIDENTIAL AND IS SUPPLIED ON THE EXPRESS CONDITION THAT IT IS NOT TO BE USED FOR ANY PURPOSE OR COPIED OR COMMUNICATED TO ANY OTHER PERSON WITHOUT WRITTEN PERMISSION FROM DART AEROSPACE LTD.		DS	PH	DRAWING NO.	REV. B
		CHECKED	APPROVED	D2989	SHEET 2 OF 3
		DATE		TITLE	SCALE
		05.06.07		BASKET LID ASSEMBLY	1:10

RELEASED



05.08.19

SHOP COPY
RETURN TO
ENGINEERING
UNCONTROLLED COPY
SUBJECT TO AMENDMENT
WITHOUT NOTICE
WORK ORDER
NO. 38726B

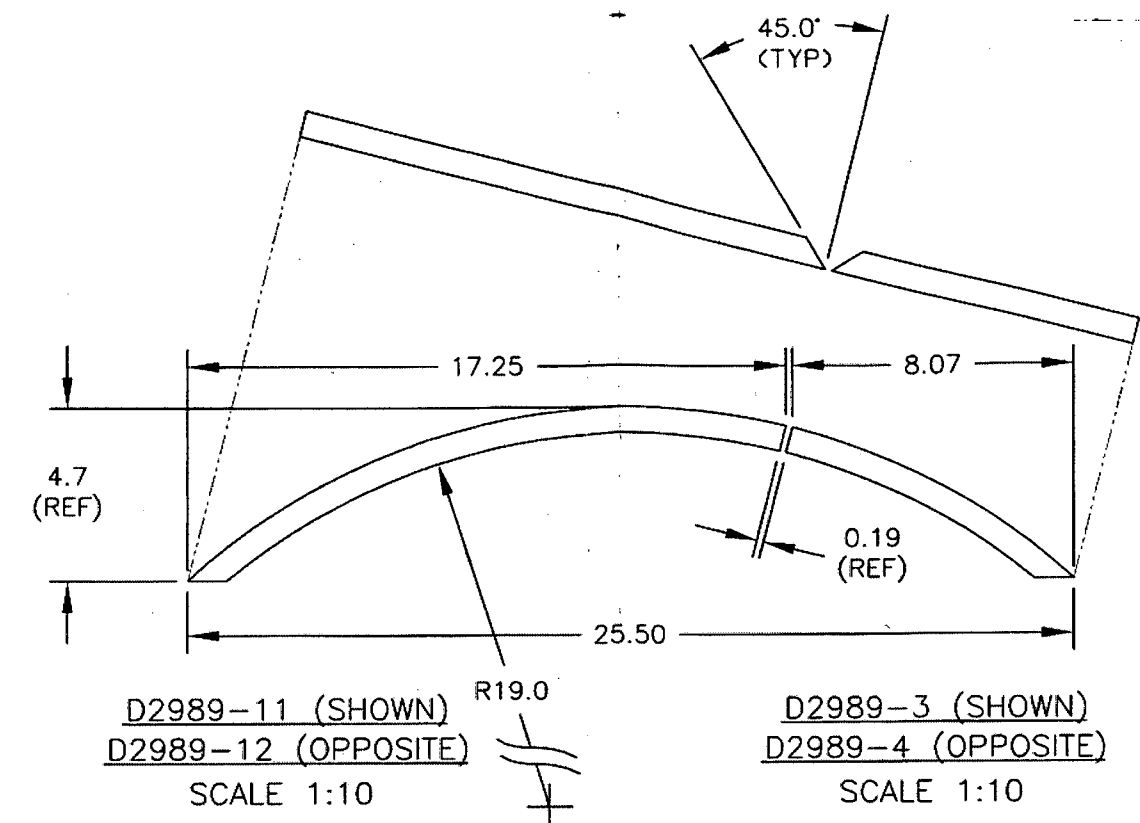
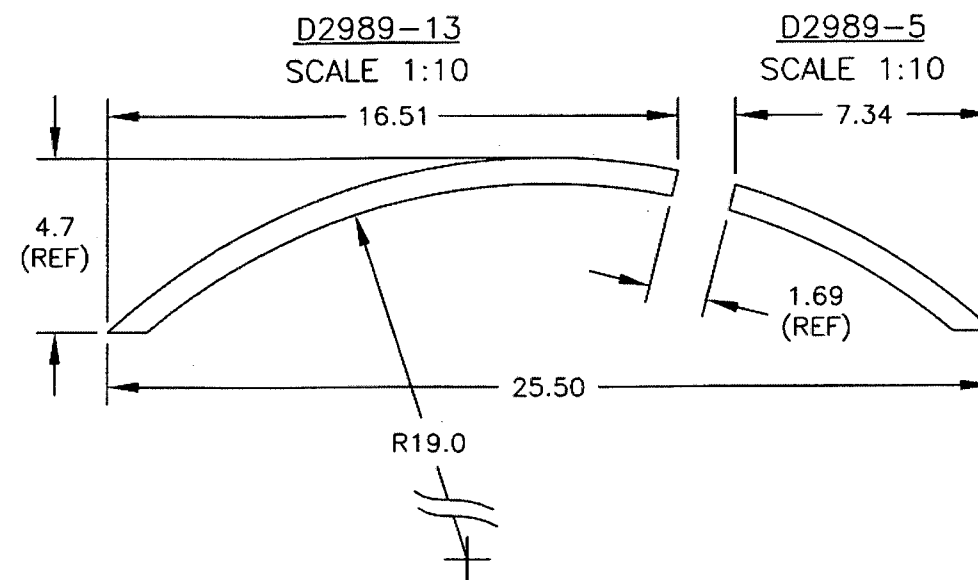


D2989-15
SCALE 2:5
(DIMENSIONS LISTED AS REFERENCE ONLY, CUT TO FIT ASSEMBLY)

D2989-7
SCALE 2:5
(DIMENSIONS LISTED AS REFERENCE ONLY, CUT TO FIT ASSEMBLY)

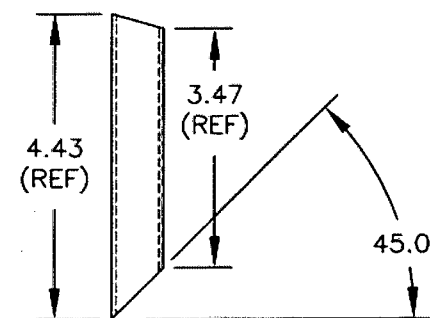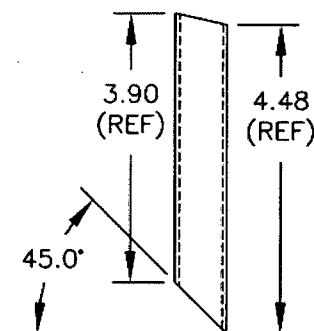

D2989-9 (SHOWN)
D2989-10 (SIMILAR)
SCALE 2:5

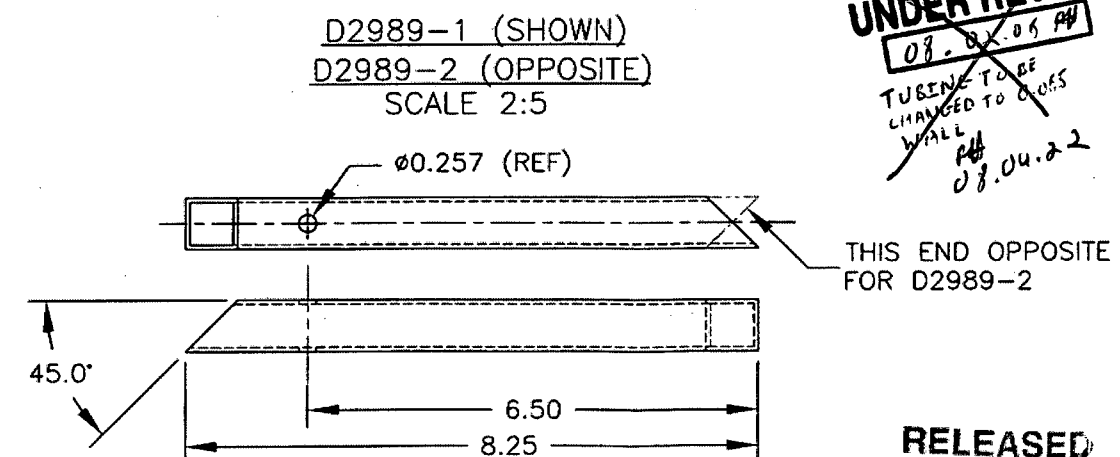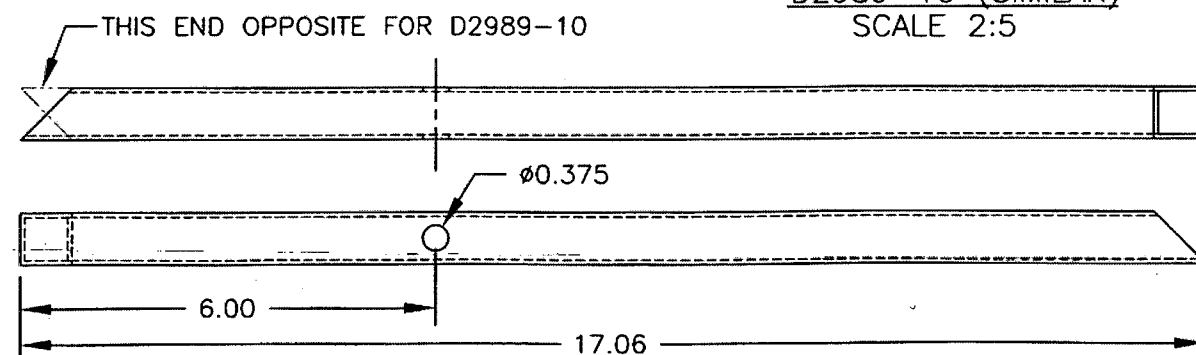

UNDER REVIEW
08.08.06 PH
TUBING TO BE
CHANGED TO 0.065
WALL
PH
08.04.22

RELEASED
05.08.19

COPYRIGHT © 2000 BY DART AEROSPACE LTD.

THIS DOCUMENT IS PRIVATE AND CONFIDENTIAL AND IS SUPPLIED ON THE EXPRESS CONDITION THAT IT IS NOT TO BE USED FOR ANY PURPOSE OR COPIED OR COMMUNICATED TO ANY OTHER PERSON WITHOUT WRITTEN PERMISSION FROM DART AEROSPACE LTD.

DESIGN DS	DRAWN BY PH	DART	DART AEROSPACE LTD. HAWKESBURY, ONTARIO, CANADA
CHECKED PH	APPROVED PH	DRAWING NO. D2989	REV. B SHEET 3 OF 3
DATE 05.06.07	TITLE BASKET LID ASSEMBLY	SCALE 1:10	

SHOP COPY
RETURN TO
ENGINEERING
UNCONTROLLED COPY
SUBJECT TO AMENDMENT
WITHOUT NOTICE
WORK ORDER
NO. 38726B